

**MISSISSIPPI DEPARTMENT OF ENVIRONMENTAL QUALITY**

Office of Land and Water Resources

P. O. Box 10631  
Jackson, MS 39289-0631  
**WATER WELL DRILLERS LOG**

COUNTY WELL LOCATED <i>Pike</i>	
WELL NUMBER <i>F 2113</i>	CODE #
DATE WELL COMPLETED <i>3-4-93</i>	

PERMIT NUMBER
NAME OF DRILLING FIRM <i>F. TIGERKALA well serv</i>

NAME & MAILING ADDRESS OF LANDOWNER <i>Boque Chito motor sports</i> <i>RR. McComb, ms -</i>			
WELL LOCATION: SEC	TOWNSHIP	RANGE	
<i>6</i>	<i>3</i>	<i>9</i>	<i>W</i>
DISTANCE	DIRECTION	NEAREST TOWN	
<i>6</i> Miles	<i>E</i>	of <i>McComb</i>	
OTHER LANDMARK			
WELL PURPOSE: Home, Irrigation, Municipal, Industrial, Fish Pond, etc. <i>RACE - mud bog -</i>			

PUMP DATA		
PUMP TYPE (Circle One): <input checked="" type="radio"/> Submersible, <input type="radio"/> Turbine, <input type="radio"/> Jet <input type="radio"/> Flowing Well, Other (Describe) _____		
POWER-TYPE (Circle One): <input checked="" type="radio"/> Electric, <input type="radio"/> Tractor, <input type="radio"/> Diesel, <input type="radio"/> Gasoline, <input type="radio"/> Butane, Other (Describe) _____ H/P <i>1/2</i>		
Pump Capacity (GPM) <i>10</i>	No. of Stages <i>8</i>	Setting Depth <i>60</i> FT.
PUMP TEST		
Well yielded <i>50</i> GPM with a drawdown of <i>1</i> ft. after <i>1</i> hours of pumping		

WELL DATA		
Well Depth <i>94</i>	Casing Diameter (In.) <i>4</i>	Casing Length (Ft.) <i>84</i>
Type of Casing <i>PVC</i>	Hole Depth <i>94</i>	Depth to Static Water Level <i>12</i>
TYPE OF COMPLETION: (Circle One or More): <input checked="" type="checkbox"/> Gravel Packed, <input type="checkbox"/> Underreamed, <input type="checkbox"/> Telescoped, <input type="checkbox"/> Natural Development, <input type="checkbox"/> Open Hole, <input type="checkbox"/> Other (Describe) _____		
WELL GROUTED TO A DEPTH OF <i>10</i> FEET Type Grout (circle one): <input checked="" type="radio"/> Cement, <input type="radio"/> Bentonite, <input type="radio"/> or <input type="radio"/> Mix		

LOG DATA	
TYPE OF LOG RUN (Circle One): <input type="radio"/> Electric, <input type="radio"/> Gamma Ray, <input type="radio"/> Density, <input type="radio"/> Sonic, <input checked="" type="radio"/> Neutron, Other (Describe) _____	
Name of Organization Running Log	

SCREEN DATA		
Diameter - Inches <i>4</i>	Length - Feet <i>10</i>	Slot Size - Inches <i>10/14</i>
Screen Type <i>PVC</i>	Depth to Bottom - Feet <i>94</i>	

GEOLOGIC DATA (Office Use Only)			
Surface Elev.	Geologic Unit	Unit Thickness	Depth to Top
Subs. SWL	Date	Analysis	Aquifer Test
Driller's Remarks			

DESCRIPTION OF FORMATIONS ENCOUNTERED	FROM	TO	FORMATIONS (Continued)	FROM	TO
<i>Red clay</i>	<i>0</i>	<i>10</i>			
<i>Fine SSM</i>	<i>10</i>	<i>70</i>			
<i>Coarse SSM + sand</i>	<i>70</i>	<i>94</i>			

**RECEIVED**


MAR 31 1993

Dept. of Environmental Quality  
Office of Land & Water Resources

IF MORE SPACE IS NEEDED, USE BACK

If well telescopes please sketch and show depths.

GROUND LEVEL

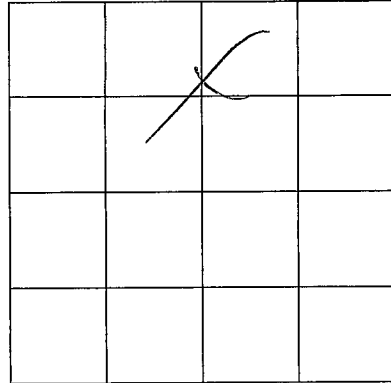

SECTION 6

Please indicate well location X.

ADDITIONAL INFORMATION

If more than one screen,  
show location of each on sketch.