

MISSISSIPPI DEPARTMENT OF ENVIRONMENTAL QUALITY

Office of Land and Water Resources

P. O. Box 10631
Jackson, MS 39289-0631
WATER WELL DRILLERS LOG

COUNTY WELL LOCATED <i>Pike</i>	
WELL NUMBER <i>F 2114</i>	CODED <i>2</i>
DATE WELL COMPLETED <i>3-2-93</i>	

PERMIT NUMBER
NAME OF DRILLING FIRM <i>R-GERALD well serv</i>

NAME & MAILING ADDRESS OF LANDOWNER <i>Vicki Cothern</i> <i>R.R. McClumb MS</i>			
WELL LOCATION:	SEC	TOWNSHIP	RANGE
	<i>27</i>	<i>3</i>	<i>N 9 E</i>
DISTANCE	DIRECTION	NEAREST TOWN	
<i>1 1/2</i> Miles	<i>E</i>	of <i>Holmesville</i>	
OTHER LANDMARK			
WELL PURPOSE: Home, Irrigation, Municipal, Industrial, Fish Pond, etc. <i>Home</i>			

PUMP DATA			
PUMP TYPE (Circle One): <input checked="" type="checkbox"/> Submersible, <input type="checkbox"/> Turbine, <input type="checkbox"/> Jet <input type="checkbox"/> Flowing Well, Other (Describe) _____			
POWER TYPE (Circle One): <input checked="" type="checkbox"/> Electric, <input type="checkbox"/> Tractor, <input type="checkbox"/> Diesel, <input type="checkbox"/> Gasoline, <input type="checkbox"/> Butane, Other (Describe) _____ H/P <i>1/2</i>			
Pump Capacity (GPM)	No. of Stages	Setting Depth	
<i>10</i>	<i>8</i>	<i>50</i> FT.	
PUMP TEST			
Well yielded <i>20</i> GPM with a drawdown of <i>2</i> ft. after <i>2</i> hours of pumping			

WELL DATA		
Well Depth <i>80</i>	Casing Diameter (In.) <i>4</i>	Casing Length (Ft.) <i>70</i>
Type of Casing <i>PVC</i>	Hole Depth <i>80</i>	Depth to Static Water Level <i>21</i>
TYPE OF COMPLETION: (Circle One or More): <input checked="" type="checkbox"/> Gravel Packed, <input type="checkbox"/> Underreamed, <input type="checkbox"/> Telescoped, <input type="checkbox"/> Natural Development, <input type="checkbox"/> Open-Hole, <input type="checkbox"/> Other		

LOG DATA	
TYPE OF LOG RUN (Circle One): <input checked="" type="checkbox"/> No Log Run, <input type="checkbox"/> Electric, <input type="checkbox"/> Gamma Ray, <input type="checkbox"/> Density, <input type="checkbox"/> Sonic, <input type="checkbox"/> Neutron, Other (Describe) _____	
Name of Organization Running Log	

WELL GROUTED TO A DEPTH OF <i>10</i> FEET Type Grout (circle one): Cement, Bentonite, or Mix

GEOLOGIC DATA (Office Use Only)			
Surface Elev.	Geologic Unit	Unit Thickness	Depth to Top
Subs. SWL	Date	Analysis	Aquifer Test
Driller's Remarks			

SCREEN DATA		
Diameter - Inches <i>4</i>	Length - Feet <i>10</i>	Slot Size - Inches <i>10/14</i>
Screen Type <i>PVC</i>	Depth to Bottom - Feet <i>80</i>	

DESCRIPTION OF FORMATIONS ENCOUNTERED	FROM	TO	FORMATIONS (Continued)	FROM	TO
<i>Red clay</i>	<i>0</i>	<i>10</i>			
<i>FINE SAND</i>	<i>10</i>	<i>62</i>			
<i>COURSE SAND & GRAVEL</i>	<i>62</i>	<i>80</i>			

RECEIVED


MAR 31 1993

Dept. of Environmental Quality
Office of Land & Water Resources

IF MORE SPACE IS NEEDED, USE BACK

If well telescopes please sketch and show depths.

GROUND LEVEL

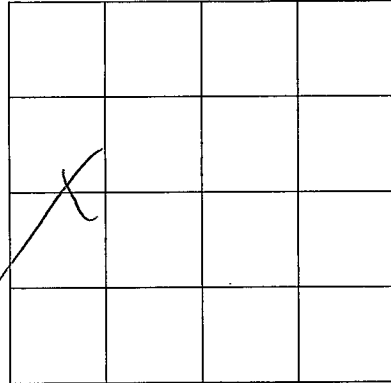

SECTION 27

Please indicate well location X.

ADDITIONAL INFORMATION

If more than one screen,
show location of each on sketch.