

LIKE
F 2110

MISSISSIPPI
BOARD OF WATER COMMISSIONERS
416 North State Street
Jackson, Mississippi 39201

WATER WELL DRILLERS LOG

Mar 30 1994 FILLBERND Well Serv P.R. Co.
date well completed firm name county well located

LANDOWNER:	description of formations encountered	from	to
George Holmes			
P.O. Box 2, McComb, Miss. (mailing address)	Red clay Red sand white chalk	0 20 80	20 80 146
WELL LOCATION:	Cone Sandstone	146	160
sec. 32 T 3 N R 9 E S W			
7 miles E of McComb (distance) (direction) (nearest town)			
WELL PURPOSE: Home (home, irrigation, municipal, industrial)			
WELL COMPLETION DATA:			
(1) diameter (inches) 4			
(2) total depth (feet) 160			
(3) static water level (feet) 57 below top of ground. above			
(4) casing PVC 150 (material) (depth)			
4 (size) if telescope see back.			
(5) screen 10 150 (length) (depth to top)			
4 (size) PVC (material)			
(6) pump 1/2 10 (HP) (yield gpm)			
ch (type power)			
(7) electric log 210 (yes or no)			
(organization running log)			
(8) how well bottom plugged Sandstone			
DRILLERS REMARKS:			


RECEIVED

JUN 17 1994

Dept. of Environmental Quality
Office of Land & Water Resources

If well telescopes please sketch and show depths.

GROUND LEVEL

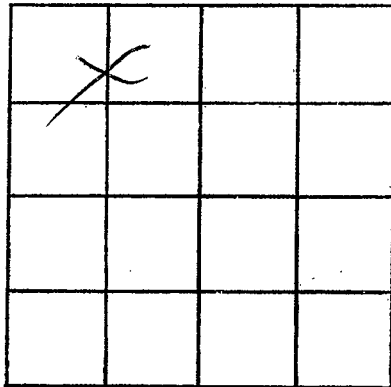

SECTION 32

Please indicate well location X.

ADDITIONAL INFORMATION

Lined area for additional information.

If more than one screen, show locations of each on sketch.