

PIKE
F 2007

MISSISSIPPI
BOARD OF WATER COMMISSIONERS
416 North State Street
Jackson, Mississippi 39201

WATER WELL DRILLERS LOG

MAR 8 1994 F. F. FERGUSON Well Service P. Re
date well completed firm name county well located

LANDOWNER:
MARTIN Davidson
RR-2, McComb, MS
(mailing address)

description of formations encountered	from	to
Red Clay	0	20
Red Sand	20	98
Coarse Sandstone	98	114

WELL LOCATION:
sec. 32 T 3 N R 9 E
S W
8 miles E of McComb
(distance) (direction) (nearest town)

WELL PURPOSE: Private House
(home, irrigation, municipal, industrial)

- WELL COMPLETION DATA:
- (1) diameter (inches) 4
 - (2) total depth (feet) 114
 - (3) static water level (feet) 72 below top of ground.
 - (4) casing PVC, 104' (material) (depth)
4" (size) If telescope see back.
 - (5) screen 10' (length) 104' (depth to top)
4" (size) PVC (material)
 - (6) pump 1 HP 20 (yield gpm)
Electric (type power)
 - (7) electric log No (yes or no)
(organization running log)
 - (8) how well bottom plugged Sand Plug

RECEIVED


JUN 17 1994

Dept. of Environmental Quality
Office of Land & Water Resources

DRILLERS REMARKS:

If well telescopes please sketch and show depths.

GROUND LEVEL

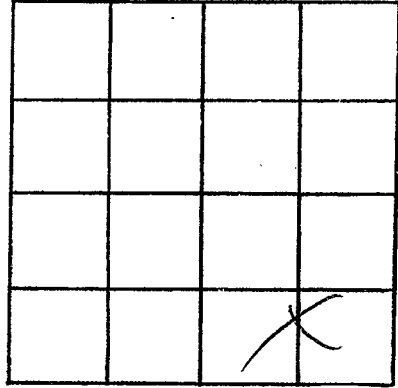

SECTION 32

Please indicate well location X.

ADDITIONAL INFORMATION

If more than one screen,
show locations of each on sketch.