

PIKE  
F 2118

MISSISSIPPI  
BOARD OF WATER COMMISSIONERS  
416 North State Street  
Jackson, Mississippi 39201

WATER WELL DRILLERS LOG

MARCH 7 1994 E. ALBERTSON Well Services P.R.  
date well completed firm name county well located

LANDOWNER:	description of formations encountered	from	to
<u>MARTIN DAVIDSON</u>			
<u>RR. 2, McComb, MS</u> (mailing address)	<u>Red Clay</u> <u>Red Sand</u> <u>Coarse Sand &amp; Gravel</u>	<u>0</u> <u>15</u> <u>94</u>	<u>15</u> <u>94</u> <u>110</u>
WELL LOCATION:			
sec. <u>32</u> T. <u>3</u> N R. <u>9</u> E S W			
<u>8</u> miles <u>E</u> of <u>McComb</u> (distance) (direction) (nearest town)			
WELL PURPOSE: <u>Mont-Pel House</u> (home, irrigation, municipal, industrial)			
WELL COMPLETION DATA:			
(1) diameter (inches) <u>4</u>			
(2) total depth (feet) <u>110</u>			
(3) static water level (feet) <u>71</u> <del>above</del> below top of ground.			
(4) casing <u>PVC</u> , <u>100</u> (material) (depth) <u>4</u> if telescope see back. (size)			
(5) screen <u>10</u> , <u>100</u> (length) (depth to top)			
<u>4</u> , <u>PVC</u> (size) (material)			
(6) pump <u>1</u> , <u>20</u> (HP) (yield gpm)			
<u>Electric</u> (type power)			
(7) electric log <u>No</u> (yes or no)			
(8) how well bottom plugged <u>Small</u>			
DRILLERS REMARKS:			


RECEIVED

JUN 17 1994

Dept. of Environmental Quality  
Office of Land & Water Resources

If well telescopes please sketch and show depths.

GROUND LEVEL

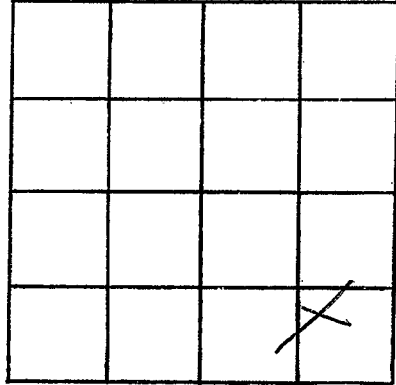

SECTION 32

Please indicate well location X.

ADDITIONAL INFORMATION

If more than one screen, show locations of each on sketch.