

**MISSISSIPPI DEPARTMENT OF ENVIRONMENTAL QUALITY**

Office of Land and Water Resources

P. O. Box 10631  
Jackson, MS 39289-0631  
**WATER WELL DRILLERS LOG**

COUNTY WELL LOCATED <i>Pike</i>	
WELL NUMBER <i>F 2139</i>	CODED
DATE WELL COMPLETED <i>11-10-98</i>	

PERMIT NUMBER
NAME OF DRILLING FIRM <i>Fitzgerald Well</i>

NAME & MAILING ADDRESS OF LANDOWNER <i>Bob Barrows</i>			
<i>Fanny Quin Rd.</i>			
WELL LOCATION:	SEC	TOWNSHIP	RANGE
	<i>15</i>	<i>3</i>	<i>9</i> <sup>(E)</sup> / <sub>(W)</sub>
DISTANCE	DIRECTION	NEAREST TOWN	
<i>11</i> Miles	<i>EAST</i>	of <i>McComb</i>	
OTHER LANDMARK			
WELL PURPOSE: <input checked="" type="radio"/> Home, Irrigation, Municipal, Industrial, Fish Pond, etc.			

<b>PUMP DATA</b>		
PUMP TYPE (Circle One): <input checked="" type="radio"/> Submersible    Turbine,    Jet    Flowing Well, Other (Describe) _____		
POWER TYPE (Circle One): <input checked="" type="radio"/> Electric    Tractor,    Diesel,    Gasoline,    Butane, Other (Describe) _____    H/P <i>1/3</i>		
Pump Capacity (GPM) <i>12</i>	No. of Stages <i>9</i>	Setting Depth <i>40'</i> FT.
PUMP TEST		
Well yielded _____ GPM with a drawdown of _____ ft. after _____ hours of pumping		


<b>WELL DATA</b>		
Well Depth <i>90</i>	Casing Diameter (In.) <i>4"</i>	Casing Length (Ft.) <i>80"</i>
Type of Casing <i>Pvc</i>	Hole Depth <i>90'</i>	Depth to Static Water Level <i>8"</i>
TYPE OF COMPLETION: (Circle One or More): <input checked="" type="radio"/> Gravel Packed, <input type="radio"/> Underreamed, <input type="radio"/> Telescoped, <input type="radio"/> Natural Development, <input type="radio"/> Open Hole, <input type="radio"/> Other		
WELL GROUTED TO A DEPTH OF <i>10 FEET</i> Type Grout (circle one): Cement, Bentonite, or <input checked="" type="radio"/> Mix		

<b>LOG DATA</b>	
TYPE OF LOG RUN (Circle One):    No Log Run, Electric, Gamma Ray, Density, Sonic, Neutron, Other (Describe) _____	
Name of Organization Running Log	

<b>SCREEN DATA</b>		
Diameter - Inches <i>4"</i>	Length - Feet <i>10'</i>	Slot Size - Inches <i>.012</i>
Screen Type <i>Pvc</i>	Depth to Bottom - Feet <i>90'</i>	


<b>GEOLOGIC DATA (Office Use Only)</b>			
Surface Elev.	Geologic Unit	Unit Thickness	Depth to Top
Subs. SWL	Date	Analysis	Aquifer Test
Driller's Remarks			
Top of Lap Pipe or Reduction in Casing			
FEET		IF TELESCOPED OR MORE THAN ONE SCREEN: USE BACK PAGE	

DESCRIPTION OF FORMATIONS ENCOUNTERED	FROM	TO
<i>Top Soil</i>	<i>0</i>	<i>5</i>
<i>Sand &amp; gravel</i>	<i>5</i>	<i>30</i>
<i>clay</i>	<i>30</i>	<i>60</i>
<i>Fine sand</i>	<i>60</i>	<i>80</i>
<i>course sand</i>	<i>80</i>	<i>90</i>

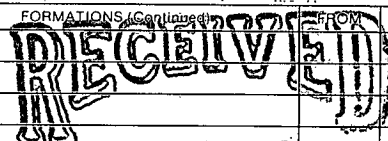FORMATIONS (Continued)		FROM	TO
			
<b>JAN 13 1999</b>			
<b>Dept. of Environmental Quality</b> <b>Office of Land &amp; Water Resources</b>			
IF MORE SPACE IS NEEDED, USE BACK			

If well telescopes please  
sketch and show depths.

GROUND LEVEL

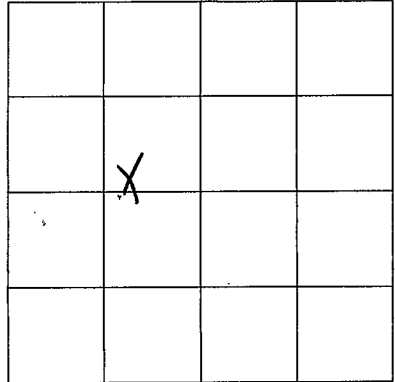

SECTION \_\_\_\_\_

Please indicate well location X.

ADDITIONAL INFORMATION

If more than one screen,  
show location of each on sketch.