

MISSISSIPPI DEPARTMENT OF ENVIRONMENTAL QUALITY
Office of Land and Water Resources

P. O. Box 10631
Jackson, MS 39289-0631
WATER WELL DRILLERS LOG

COUNTY WELL LOCATED <u>Pike</u>	
WELL NUMBER <u>P 2140</u>	CODED
DATE WELL COMPLETED <u>11-9-95.</u>	

PERMIT NUMBER
NAME OF DRILLING FIRM <u>Fitzgerald Well</u>

NAME & MAILING ADDRESS OF LANDOWNER <u>Bob Burrows,</u> <u>West Topisaw Rd.</u>			
WELL LOCATION: SEC	TOWNSHIP	RANGE	
<u>4</u>	<u>3</u>	<u>N 9</u>	<u>W</u>
DISTANCE <u>8</u> Miles	DIRECTION <u>EAST</u>	NEAREST TOWN <u>McComb</u>	
OTHER LANDMARK			
WELL PURPOSE <u>(Home)</u> Irrigation, Municipal, Industrial, Fish Pond, etc.			

PUMP DATA		
PUMP TYPE (Circle One): <u>Submersible</u> , Turbine, Jet, Flowing Well, Other (Describe)		
POWER TYPE (Circle One): <u>Electric</u> , Tractor, Diesel, Gasoline, Butane, Other (Describe) H/P <u>1/2</u>		
Pump Capacity (GPM) <u>12</u>	No. of Stages <u>9</u>	Setting Depth <u>80'</u> FT.
PUMP TEST		
Well yielded _____ GPM with a drawdown of _____ ft. after _____ hours of pumping		

WELL DATA		
Well Depth <u>100</u>	Casing Diameter (In.) <u>4"</u>	Casing Length (Ft.) <u>90'</u>
Type of Casing <u>PVC</u>	Hole Depth <u>100'</u>	Depth to Static Water Level <u>48'</u>

LOG DATA	
TYPE OF LOG RUN (Circle One): <u>Electric</u> , Gamma Ray, Density, Sonic, Neutron, Other (Describe)	
Name of Organization Running Log	

TYPE OF COMPLETION: (Circle One or More): <u>Gravel Packed</u> , Underreamed, Telescoped, Natural Development, Open Hole, Other (Describe)			
---	--	--	--

GEOLOGIC DATA (Office Use Only)			
Surface Elev.	Geologic Unit	Unit Thickness	Depth to Top
Subs. SWL	Date	Analysis	Aquifer Test

WELL GROUTED TO A DEPTH OF <u>10</u> FEET Type Grout (circle one): Cement, Bentonite, or <u>MIX</u>
--

Driller's Remarks	
Top of Lap Pipe or Reduction in Casing	
FEET	IF TELESCOPED OR MORE THAN ONE SCREEN: USE BACK PAGE


SCREEN DATA		
Diameter - Inches <u>4"</u>	Length - Feet <u>10</u>	Slot Size - Inches <u>.012</u>
Screen Type <u>PVC</u>	Depth to Bottom, Feet <u>100'</u>	

DESCRIPTION OF FORMATIONS ENCOUNTERED	FROM	TO	FORMATIONS (Continued)	FROM	TO
<u>Top Soil</u>	<u>0</u>	<u>5</u>	RECEIVED <u>UJ</u> JAN 13 1999 Dept. of Environmental Quality Office of Land & Water Resources		
<u>gravel</u>	<u>5</u>	<u>30</u>			
<u>Sand</u>	<u>30</u>	<u>60</u>			
<u>clay</u>	<u>60</u>	<u>80</u>			
<u>Sand</u>	<u>80</u>	<u>90</u>			
<u>course sand</u>	<u>90</u>	<u>100</u>			

IF MORE SPACE IS NEEDED, USE BACK

If well telescopes please
sketch and show depths.

GROUND LEVEL

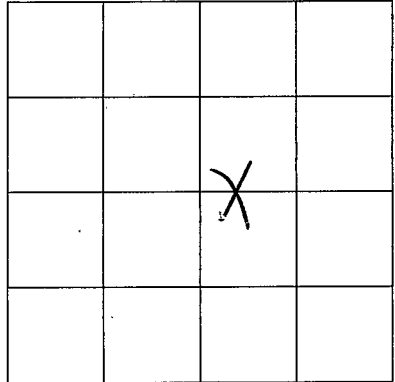

SECTION _____

Please indicate well location X.

ADDITIONAL INFORMATION

If more than one screen,
show location of each on sketch.