

MISSISSIPPI DEPARTMENT OF ENVIRONMENTAL QUALITY

Office of Land and Water Resources

P. O. Box 10631  
Jackson, MS 39289-0631  
WATER WELL DRILLERS LOG

COUNTY, WELL LOCATED  
Pike

WELL NUMBER  
F-2156

CODED

PERMIT NUMBER

NAME OF DRILLING FIRM  
Fitzgerald Well Service

DATE WELL COMPLETED  
6-27-02

NAME & MAILING ADDRESS OF LANDOWNER  
Griner Drilling (NRG) Powerplant  
River Rd. Summit

Latitude:  
Longitude:

WELL LOCATION. SEC 8 TOWNSHIP 3 RANGE 9 W

DISTANCE 8 Miles DIRECTION East of NEAREST TOWN McComb

OTHER LANDMARK

WELL PURPOSE: Home, Irrigation, Municipal, Industrial, Fish Pond, etc.  
Supply Well for Griner

PUMP DATA

PUMP TYPE (Circle One):  
 Submersible Turbine, Jet, Flowing Well,  
Other (Describe)

POWER TYPE (Circle One):  
 Electric Tractor, Diesel, Gasoline, Butane,  
Other (Describe) H/P 1/2

DESCRIPTION OF FORMATIONS ENCOUNTERED	FROM	TO
<u>Top soil</u>	<u>0</u>	<u>5</u>
<u>Sand + gravel</u>	<u>5</u>	<u>65</u>
<u>clay</u>	<u>65</u>	<u>70</u>
<u>sand</u>	<u>70</u>	<u>100</u>
<u>course sand</u>	<u>100</u>	<u>120</u>

RECEIVED  
JUL 30 2002  
BY: OLWR

Top of Lap Pipe or Reduction in Casing

FEET IF TELESKOPED OR MORE THAN ONE SCREEN: USE BACK PAGE

WELL DATA

Well Depth <u>120</u>	Casing Diameter (In.) <u>4"</u>	Casing Length (Ft.) <u>100'</u>
Type of Casing <u>PVC</u>	Hole Depth <u>120'</u>	Depth to Static Water Level <u>10'</u>

TYPE OF COMPLETION: (Circle One or More):  
 Gravel Packed,  Underreamed,  Telescoped,  
 Natural Development,  Open Hole,  Other  
(Describe)

WELL GROUTED TO A DEPTH OF 10 FEET  
Type Grout (circle one): Cement, Bentonite, or Mix (X)

SCREEN DATA

Diameter - Inches <u>4"</u>	Length - Feet <u>20'</u>	Slot Size - Inches <u>.012</u>
Screen Type <u>PVC</u>	Depth to Bottom - Feet <u>120'</u>	

I certify that the well was drilled, constructed and completed in accordance with all applicable Requirements of the Mississippi Department of Environmental Quality and/or the Mississippi Department of Health regulations and state laws.


Brad Fitzgerald 029  
Signature of Licensed Driller and License No.

7-20-02  
Date

Additional Information Required On Back

If well telescopes please sketch and show depths.

GROUND LEVEL

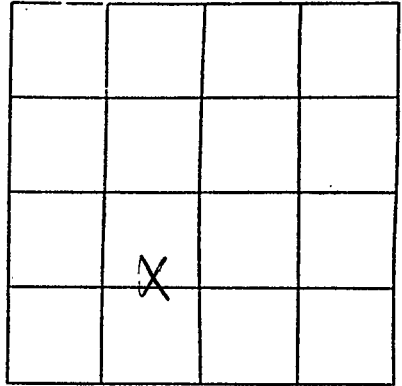

SECTION 8

Please indicate well location X.

Pump Capacity (GPM) <u>100</u>	No. of Stages	Setting Depth <u>80'</u> FT.
PUMP TEST		
Well yielded _____ GPM with a drawdown of _____ ft. after _____ hours of pumping		

LOG DATA

TYPE OF LOG RUN (Circle One):  No Log Run,  Electric,  Gamma Ray,  Density,  Sonic,  Neutron,  Other (Describe) \_\_\_\_\_

Name of Organization Running Log \_\_\_\_\_

GEOLOGIC DATA (Office Use Only)

Surface Elev.	Geologic Unit	Unit Thickness	Depth to Top
Subs. SWL	Date	Analysis	Aquifer Test

Driller's Remarks

---



---



If more than one screen, show location of each on sketch.