

Pike
 G 13
 12-12-58

MISSISSIPPI
 BOARD OF WATER COMMISSIONERS
 416 North State Street
 Jackson, Mississippi 39201

WATER WELL DRILLERS LOG

Nov 12 1968 J.T. Livingston Pike
 date well completed firm name county well located

LANDOWNER: Albert Lanning

description of formations encountered	from	to

Magnolia, Miss.
 (mailing address)

2/24	0	35
3 pnd L Rocks	35	88

WELL LOCATION:
 sec. 9 T 2 N R 7 E
 S W
 7 1/2 miles west of Magnolia
 (distance) (direction) (nearest town)

WELL PURPOSE: Home
 (home, irrigation, municipal, industrial)

- WELL COMPLETION DATA:
- (1) diameter (inches) 4"
 - (2) total depth (feet) 88'
 - (3) static water level (feet) 60' below above top of ground.
 - (4) casing Plastic 82' (material) (depth)
 (size) If telescope see back.
 - (5) screen 6' 88' (length) (depth to top)
 4" Plastic (size) (material)
 - (6) pump 1/2 (HP) 8 (yield gpm)
 A.C. (type power)
 - (7) electric log (yes or no)
 (organization running log)
 - (8) how well bottom plugged wood


DRILLERS REMARKS:

DEC 29 1968

MISS. DEPT. OF WATER CONTROL

If well telescopes please sketch and show depths.

GROUND LEVEL

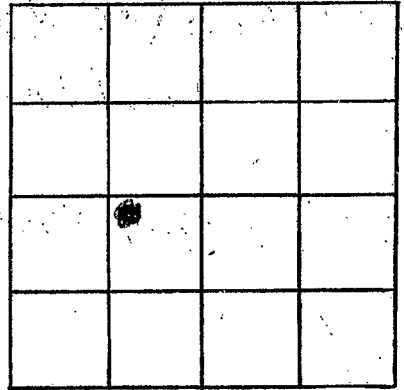

SECTION 7

Please indicate well location X.

ADDITIONAL INFORMATION

If more than one screen,
show locations of each on sketch.