

PIKE

MISSISSIPPI BOARD OF WATER COMMISSIONERS

6/8 CODED

3-20-63

WATER WELL DRILLERS LOG

CODED

Date: 3-20, 1963, Driller: Chester Reeves County: Pike

(Name)


- (1) Owner of Land: Fred Surrency
(Name)
Magnolia
(Address)
- (2) Location: 1/4, 1/4, Sec. 15 T 2 R 7
2 miles west of Magnolia
(distance) (direction) (Nearest Town)
- (3) Topography: Hilly
(Hilly) (Flat) (Level)
- (4) Purpose of Well: Domestic
(Domestic Irrigation
Municipal, Industrial, Other)

Description & Color of Materials Sand, Clay, Red Clay, Shell, etc.	Thick- ness Feet	De p
clay	20	20
Red Sand	30	50
Clay & gravel	25	75
Sand	75	89

Information upon completion of well:

- (1) Diameter 4 inches.
- (2) Total Depth 89 feet.
- (3) Water Level 58 feet below top of ground.
- (4) Cased to bottom Size 4
- (5) Screen: Size 4", Length 4"
- (6) Were any formations sealed against pollution?
yes, no.

CODED

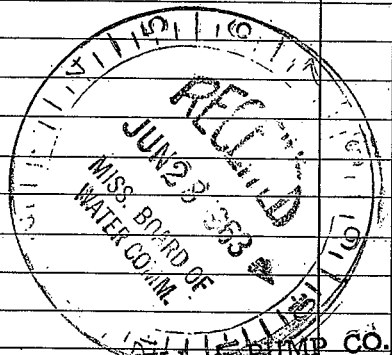

If YES depth of formation _____

Why _____

Drillers Remarks: Bad well

REEVES WELL & PUMP CO.
P. O. BOX 71 PHONE 684-1451
MCCOMB, MISS.

(Use Back Side)

Well No.

