

PIKE

MISSISSIPPI BOARD OF WATER COMMISSIONERS

G 21

4-22-64 CODED

WATER WELL DRILLERS LOG

CODED

Date: 4-22, 1964, Driller: Chester Reeves County Pike (Name)

(1) Owner of Land: Dr. A. V. Beacham  
 (Name)  
Magnolia  
 (Address)

(2) Location:  $\frac{1}{4}$ ,  $\frac{1}{4}$ , Sec. <sup>23</sup>/<sub>26</sub> T 2 R 7  
1 miles South of Magnolia  
 (distance) (direction) (Nearest Town)

(3) Topography: Hilly  
 (Hilly) (Flat) (Level)

(4) Purpose of Well: Domestic  
 (Domestic Irrigation  
 Municipal, Industrial, Other)

Description & Color of Materials Sand, Clay, Red Clay, Shell, etc.	Thickness Feet	Depth Feet
<u>Clay &amp; sand</u>	<u>25</u>	<u>25</u>
<u>Reddish clay</u>	<u>75</u>	<u>100</u>
<u>Coarse sand</u>		
<u>Small gravel</u>	<u>20</u>	<u>120</u>

Information upon completion of well:

(1) Diameter 4 inches.

(2) Total Depth 120 feet.

(3) Water Level 92 feet below top of ground.

(4) Cased to Bottom Size 4"


(5) Screen: Size 4", Length 7'

(6) Were any formations sealed against pollution?  
 yes,  no.

CODED

If YES depth of formation \_\_\_\_\_  
Why \_\_\_\_\_

Drillers Remarks: old well went bad

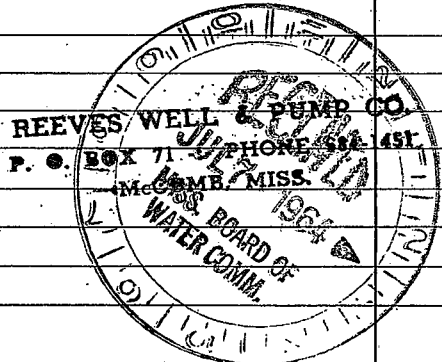

(Use Back Side)

Well No.

1912

1912

