

CODED

MISSISSIPPI
BOARD OF WATER COMMISSIONERS
416 North State Street
Jackson, Mississippi 39201

WATER WELL DRILLERS LOG

Pike
G 27
2-67

Feb 10 1967 REEVES Well & Pump PIKE
date well completed firm name county well located

LANDOWNER: AVA DILLON
RFD
Magnolia
(mailing address)

WELL LOCATION:
sec. 33 T. 2 N. R. 7 E
3 miles S.W. of Magnolia
(distance) (direction) (nearest town)

WELL PURPOSE: Home
(home, irrigation, municipal, industrial)


- WELL COMPLETION DATA:
- (1) diameter (inches) 4"
 - (2) total depth (feet) 123
 - (3) static water level (feet) 25 below above top of ground.
 - (4) casing Plastic Bottom
(material) (depth)
 - 4
(size) if telescope see back.
 - (5) screen 6' 117'
(length) (depth to top)
4" Plastic
(size) (material)
 - (6) pump 7/8 Sub 15
(HP) (yield gpm)
Electric
(type power)
 - (7) electric log no
(yes or no)
 - (organization running log)

(8) how well bottom plugged wooden plug

DRILLERS REMARKS: old well bad

| description of formations encountered | from | to |
|---------------------------------------|------|-----|
| Red clay | 0 | 18 |
| Red sand | 18 | 55 |
| Hard gravel | 55 | 70 |
| Red chalk | 70 | 80 |
| Sandy sand | 80 | 110 |
| gravel & sand | 110 | 123 |

CODED

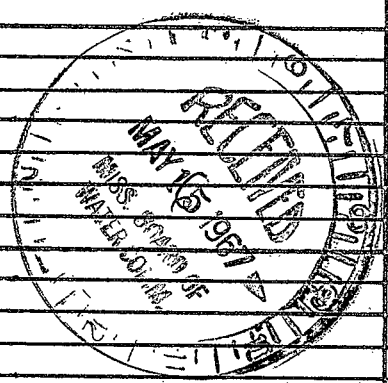

If well telescopes please sketch and show depths.

GROUND LEVEL

| | | | |
|--|--|--|---|
| | | | X |
| | | | |
| | | | |
| | | | |

SECTION 33

Please indicate well location X.

ADDITIONAL INFORMATION

If more than one screen, show locations of each on sketch.