

Pike
 G 28
 4-67

MISSISSIPPI
 BOARD OF WATER COMMISSIONERS
 416 North State Street
 Jackson, Mississippi 39201

WATER WELL DRILLERS LOG

April 5 1967 KEELER'S WELLS & Pump Pike
 date well completed firm name county well located

LANDOWNER: W.L. Powell
 RFD 3,
 Summit, MS
 (mailing address)

description of formations encountered	from	to
Red clay	0	18
Red sandy clay	18	25
Clay with sand	25	23


WELL LOCATION:
 sec 6 T 2 N R 7 E
 miles (distance) direction (nearest town)

6 miles W of Magnolia
 South side Percy Quin
 Park

WELL PURPOSE: Home
 (home, irrigation, municipal, industrial)

- WELL COMPLETION DATA:
- (1) diameter (inches) 4"
 - (2) total depth (feet) 93
 - (3) static water level (feet) 70 ^{below}/_{above} top of ground.
 - (4) casing Plastic Ballam 87
 (material) (depth)
 4" (size) If telescope see back.
 - (5) screen 6' 87
 (length) (depth to top)
 4" Plastic
 (size) (material)
 - (6) pump 1/2 HP 12
 (HP) (yield gpm)
 Electric
 (type power)
 - (7) electric log No
 (yes or no)
 (organization running log)
 - (8) how well bottom plugged
 Plug


CODED

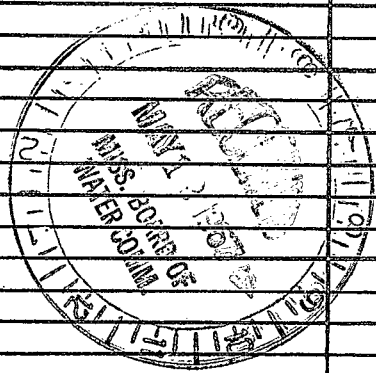

DRILLERS REMARKS:

If well telescopes please sketch and show depths.

GROUND LEVEL

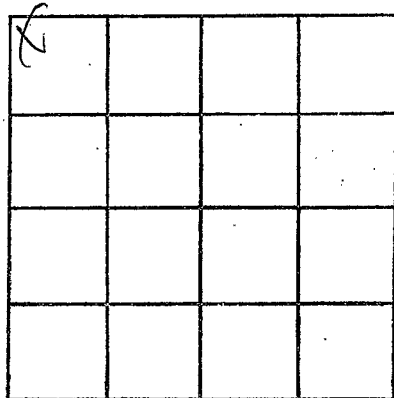

SECTION 6

Please indicate well location X.

ADDITIONAL INFORMATION

If more than one screen,
show locations of each on sketch.