

PIKE **CODED**
 G29
 7-67

MISSISSIPPI
 BOARD OF WATER COMMISSIONERS
 416 North State Street
 Jackson, Mississippi 39201

WATER WELL DRILLERS LOG

7-5 date well completed W. W. W. W. firm name pike county well located

LANDOWNER: Mrs. D. M. W. W.
St. Magnolia, Miss.
 (mailing address)

description of formations encountered	from	to
Top soil & clay	0	20
Red Sand	20	65
Sand	65	80
Sand & gravel	80	94
Chalk	94	

WELL LOCATION:
 sec 20 T 2 N R 7 E
6 miles W of Magnolia
 (distance) (direction) (nearest town)

WELL PURPOSE: home
 (home, irrigation, municipal, industrial)

- WELL COMPLETION DATA:
- (1) diameter (inches) 4
 - (2) total depth (feet) 94
 - (3) static water level (feet) 160 below above top of ground.
 - (4) casing plastic 88
 (material) (depth)
4 if telescope see back.
 (size)
 - (5) screen 6' 88
 (length) (depth to top)
4 plastic
 (size) (material)
 - (6) pump 1/2 Sub 14
 (HP) (yield gpm)
Steel
 (type power)
 - (7) electric log No
 (yes or no)
 (organization running log)
 - (8) how well bottom plugged Weld plug


CODED



DRILLERS REMARKS:

If well telescopes please sketch and show depths.

GROUND LEVEL

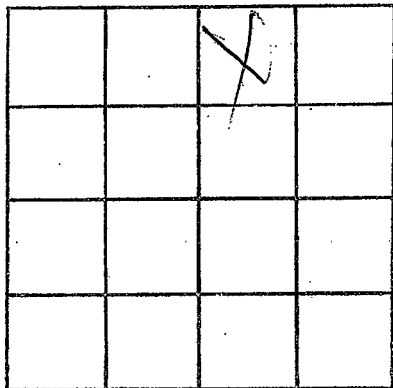

SECTION

00

Please indicate well location X.

ADDITIONAL INFORMATION

If more than one screen, show locations of each on sketch.