

CODED

MISSISSIPPI BOARD OF WATER COMMISSIONERS  
416 North State Street  
Jackson, Mississippi 39201

WATER WELL DRILLERS LOG

Pike  
G30  
9-67

Sept 19 67 date well completed  
Senechal & Humphreys, P.C. firm name  
Pike county well located

LANDOWNER: Blanche Vick  
RFD, Summit  
(mailing address)

description of formations encountered	from	to
red clay	0	18
red sand	18	65
gravel & sand	65	78
gravel & clay	78	85
small gravel & sand	85	100


WELL LOCATION:  
sec. 6 T 2 N R 7 E  
7 miles S.W. of Summit  
(distance) (direction) (nearest town)

WELL PURPOSE: Home  
(home, irrigation, municipal, industrial)

WELL COMPLETION DATA:

- (1) diameter (inches) 4
- (2) total depth (feet) 100
- (3) static water level (feet) 60 below above top of ground.
- (4) casing Plastic Bottom  
(material) (depth)  
(size) if telescope see back.
- (5) screen 6 94'  
(length) (depth to top)  
4" Plastic  
(size) (material)
- (6) pump 3/4 hp 8  
(HP) (yield gpm)  
Electric  
(type power)
- (7) electric log NO  
(yes or no)  
(organization running log)
- (8) how well bottom plugged water tight

CODED

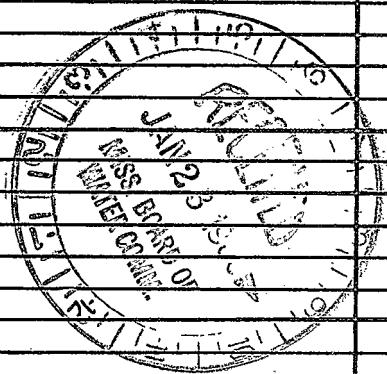

DRILLERS REMARKS:  
New house.

If well telescopes please sketch and show depths.

GROUND LEVEL

X			

SECTION 6

Please indicate well location X.

ADDITIONAL INFORMATION

If more than one screen, show locations of each on sketch.