

Pike  
G31  
10-67

MISSISSIPPI  
BOARD OF WATER COMMISSIONERS  
416 North State Street  
Jackson, Mississippi 39201

WATER WELL DRILLERS LOG

10 23 19 67 Fitzgerald Water Well Serv - Pike  
date well completed firm name county well located

LANDOWNER: Mrs Mary Bilbo  
Magnolia Miss  
(mailing address)

description of formations encountered	from	to
top soil clay	0	10
red sand	10	40
gravelly sand	40	62
red chalk	62	68
fine sand	68	80
coarse sand & gravel	80	100

WELL LOCATION:  
sec 13 T 2 N 7 E  
S W  
1/2 miles 5 of Magnolia  
(distance) (direction) (nearest town)

WELL PURPOSE: Domestic  
(home, irrigation, municipal, industrial)

WELL COMPLETION DATA:

(1) diameter (inches) 4

(2) total depth (feet) 98

(3) static water level (feet) 65 below/above top of ground.

(4) casing plastic 92'  
(material) (depth)  
4 if telescope see back.  
(size)

(5) screen 6' 92'  
(length) (depth to top)  
4 plastic  
(size) (material)

(6) pump 1/2 Subm. 15'  
(HP) (yield gpm)  
Spec  
(type power)

(7) electric log No  
(yes or no)  
Woodpeck  
(organization running log)

(8) how well bottom plugged


CODED



DRILLERS REMARKS:

If well telescopes please sketch and show depths.

GROUND LEVEL

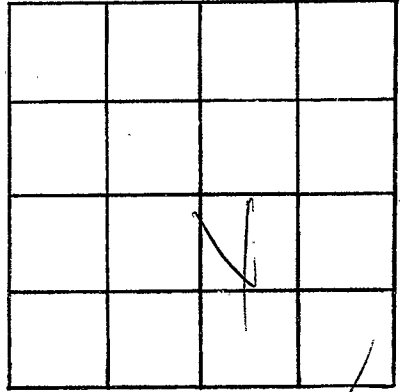

SECTION           

Please indicate well location X.

ADDITIONAL INFORMATION

If more than one screen, show locations of each on sketch.