

Pike
G32
2-68

COVERED

MISSISSIPPI
BOARD OF WATER COMMISSIONERS
416 North State Street
Jackson, Mississippi 39201

WATER WELL DRILLERS LOG

Feb 6 1968 Keene well pumps Pike
date well completed firm name county well located

LANDOWNER: Bruce
M. Lamb
Magnolia
(mailing address)

description of formations encountered	from	to
Red clay	0	8
Red sand	8	36
Small gravel	36	40
sand	40	62
Red gravel	62	67

WELL LOCATION:
sec. 13 T. 2 N. R. 1 E
1/4 miles S.E. of Magnolia
(distance) (direction) (nearest town)


WELL PURPOSE: Home
(home, irrigation, municipal, industrial)

- WELL COMPLETION DATA:
- (1) diameter (inches) 4"
 - (2) total depth (feet) 67
 - (3) static water level (feet) 45 below top of ground
 - (4) casing Plastic bottom
(material) (depth)
 - (size) If telescope see back.
 - (5) screen 6' 6"
(length) (depth to top)
4" Plastic
(size) (material)
 - (6) pump 1/2 HP - 8
(HP) (yield gpm)
elect
(type power)
 - (7) electric log no
(yes or no)
 - (organization running log)

(8) how well bottom plugged
wooden plug


DRILLERS REMARKS:
old well bad

COVERED

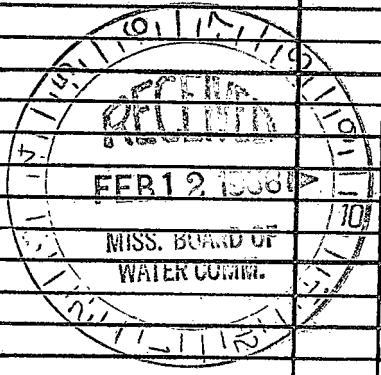

If well telescopes please sketch and show depths.

GROUND LEVEL

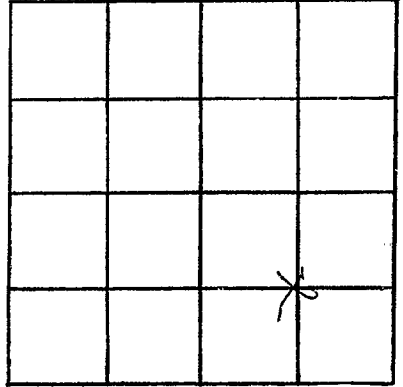

SECTION 13

Please indicate well location X.

ADDITIONAL INFORMATION

If more than one screen, show locations of each on sketch.