

PIKE  
G33  
3-68

MISSISSIPPI  
BOARD OF WATER COMMISSIONERS  
416 North State Street  
Jackson, Mississippi 39201

WATER WELL DRILLERS LOG

Mar-16 1968 J.T. Covington Pike  
date well completed firm name county well located

LANDOWNER: ~~CADDO~~ ~~W. Moore~~  
Magnolia, Miss

description of formations encountered

from to

(mailing address)

clay sand 0 20  
clay 20 50  
rock L sand 50 60  
60 85

WELL LOCATION:


sec. 14 T 2 N R 7 E  
S W  
3 miles west of Magnolia  
(distance) (direction) (nearest town)

WELL PURPOSE: Home  
(home, irrigation, municipal, industrial)

WELL COMPLETION DATA:

- (1) diameter (inches) 4"  
(2) total depth (feet) 85'  
(3) static water level (feet) 50' below above top of ground.  
(4) casing Plastic, 3"  
(material) (depth)  
\_\_\_\_\_ if telescope see back.  
(size)  
(5) screen 6', 79'  
(length) (depth to top)  
4", Plastic  
(size) (material)  
(6) pump 1/2, 5  
(HP) (yield gpm)  
A.C.  
(type power)  
(7) electric log \_\_\_\_\_  
(yes or no)  
\_\_\_\_\_  
(organization running log)  
(8) how well bottom plugged none

CODED

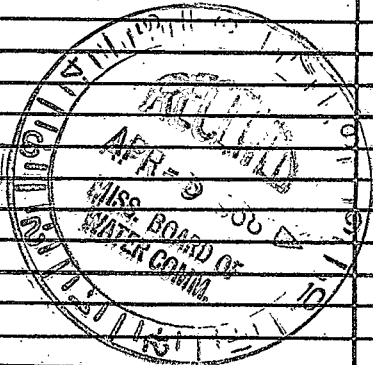

DRILLERS REMARKS:

If well telescopes please sketch and show depths.

GROUND LEVEL


SECTION 14

Please indicate well location X.

ADDITIONAL INFORMATION

If more than one screen, show locations of each on sketch.