

**MISSISSIPPI  
BOARD OF WATER COMMISSIONERS**  
416 North State Street  
Jackson, Mississippi 39201

**WATER WELL DRILLERS LOG**

*Pike*  
634  
6-68

6-11 19 58 *Fitzgerald Well Serv* *Pike*  
date well completed firm name county well located

LANDOWNER: *C.W. Cook*

description of formations encountered	from	to
	<i>Reel clay</i>	<i>0</i>
<i>Reel sand</i>	<i>20</i>	<i>80</i>
<i>Reel gravel</i>	<i>80</i>	<i>100</i>
<i>Reel clay</i>	<i>100</i>	<i>135</i>
<i>Cause sand</i>	<i>135</i>	<i>152</i>

*R.R. Magnolia Miss.*  
(mailing address)

WELL LOCATION:  
sec. *36* T. *2* N R. *8* E  
*9* miles *SW* of *Magnolia*  
(distance) (direction) (nearest town)

WELL PURPOSE: *Home*  
(home, irrigation, municipal, industrial)

WELL COMPLETION DATA:

- (1) diameter (inches) *4*
- (2) total depth (feet) *152*
- (3) static water level (feet) *100* below above top of ground.
- (4) casing *Plastic*, *146*,  
(material) (depth)  
*4* if telescope see back.  
(size)
- (5) screen *6*, *146*  
(length) (depth to top)  
*4"*, *Plastic*  
(size) (material)
- (6) pump *7*, *7*  
(HP) (yield gpm)  
*Electric*  
(type power)
- (7) electric log *Yes*  
(yes or no)  
(organization running log)
- (8) how well bottom plugged *wool fly*


DRILLERS REMARKS:

**CODER**

**JUL 15 1958  
MISS. BOARD OF  
WATER COM.**

If well telescopes please sketch and show depths.

GROUND LEVEL

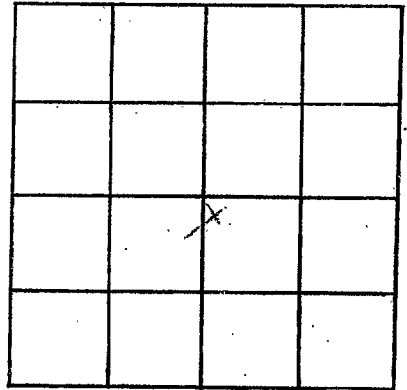

SECTION 36

Please indicate well location X.

ADDITIONAL INFORMATION

If more than one screen,  
show locations of each on sketch.