

Pike
 G35
 7-68

INDEXED

MISSISSIPPI
 BOARD OF WATER COMMISSIONERS
 416 North State Street
 Jackson, Mississippi 39201

WATER WELL DRILLERS LOG

July 8 1968 Reeveswell Pump Pike
 date well completed firm name county well located

LANDOWNER: Sandy Simmons
 Magnolia
 (mailing address)

WELL LOCATION:
 sec. 23 T. 2 N. R. 7 E
 1 miles SW Magnolia
 (distance) (direction) (nearest town)

WELL PURPOSE: Home
 (home, irrigation, municipal, industrial)

WELL COMPLETION DATA:

- (1) diameter (inches) 4"
- (2) total depth (feet) 108
- (3) static water level (feet) 80 below top of ground.
- (4) casing Plastic Bottom
 (material) (depth)
- (size) If telescope see back.
- (5) screen 6' 102
 (length) (depth to top)
- 4" Plastic
 (size) (material)
- (6) pump 1/2 Sub 171
 (HP) (yield gpm)
- Sub
 (type power)
- (7) electric log No
 (yes or no)

(organization running log)

(8) how well bottom plugged
 woodchips

DRILLERS REMARKS:
 New house.


description of formations encountered	from	to
Red clay	0	18
Red Sand	18	40
big gravel & sand	40	82
pink sandy sand	82	90
pink chalk	90	97
small gravel & sand	97	108

INDEXED

MISSISSIPPI
 BOARD OF WATER COMMISSIONERS
 JUL 12 1968

If well telescopes please sketch and show depths.

GROUND LEVEL

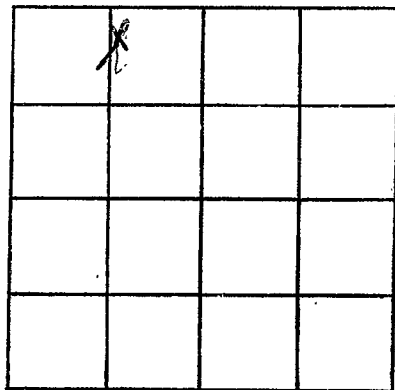

SECTION 23

Please indicate well location X.

ADDITIONAL INFORMATION

If more than one screen, show locations of each on sketch.