

**MISSISSIPPI
BOARD OF WATER COMMISSIONERS
416 North State Street
Jackson, Mississippi 39201**

WATER WELL DRILLERS LOG

Pike
636
7-68

CODED

July 9 1968 Reverwell Pump Pike
 date well completed firm name county well located

LANDOWNER: C.M. Lane, Jr
Magnolia
 (mailing address)

WELL LOCATION:
 sec 22 T 2 N R 7 E
2 miles SW of Magnolia
 (distance) (direction) (nearest town)

WELL PURPOSE: Home
 (home, irrigation, municipal, industrial)

WELL COMPLETION DATA:

(1) diameter (inches) 4"

(2) total depth (feet) 80

(3) static water level (feet) 50 below top of ground.

(4) casing plastic Bottom
 (material) (depth)

_____ if telescope see back.
 (size)

(5) screen 6' 74'
 (length) (depth to top)

4" plastic
 (size) (material)

(6) pump 1/2 Sub 12
Electric
 (HP) (yield gpm)
 (type power)

(7) electric log no
 (yes or no)

_____ (organization running log)

(8) how well bottom plugged woodruff

| description of formations encountered | from | to |
|---------------------------------------|------|----|
| Red clay & gravel | 0 | 12 |
| Red sand | 12 | 20 |
| sand, chalk & gravel | 20 | 38 |
| white chalk | 38 | 57 |
| Small gravel & sand | 57 | 80 |


CODED

SEP 15 1968
 MISS. BOARD OF
 WATER COMMISSIONERS

DRILLERS REMARKS:
New house

If well telescopes please sketch and show depths.

GROUND LEVEL

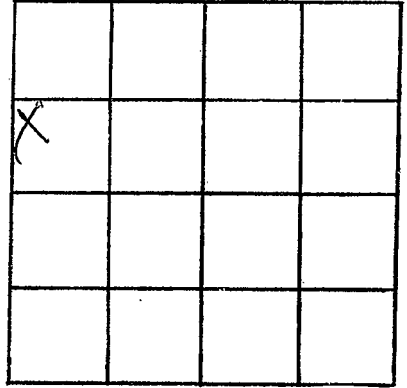

SECTION 22

Please indicate well location X.

ADDITIONAL INFORMATION

If more than one screen, show locations of each on sketch.