

Pike
 G37
 7-68 CODED

MISSISSIPPI
 BOARD OF WATER COMMISSIONERS
 416 North State Street
 Jackson, Mississippi 39201

WATER WELL DRILLERS LOG

July 20 1968 D.T. Covington Pike
 date well completed firm name county well located

LANDOWNER: Jim Green

description of formations encountered

	from	to
--	------	----

Magnolia, Miss
 (mailing address)

<u>2' sand</u>	<u>0</u>	<u>33</u>
<u>Sand & rocks</u>	<u>30</u>	<u>86</u>

WELL LOCATION:
 sec. 17 T. 2 N R. 7 E
9 SE S NE W
9 miles west of Magnolia
 (distance) (direction) (nearest town)


WELL PURPOSE: Home
 (home, irrigation, municipal, industrial)

WELL COMPLETION DATA:

- (1) diameter (inches) 4"
- (2) total depth (feet) 86'
- (3) static water level (feet) 68' below above top of ground.
- (4) casing Plastic 80'
 (material) (depth)
4" if telescope see back.
 (size)
- (5) screen 6' 86'
 (length) (depth to top)
4" Plastic
 (size) (material)
- (6) pump 2 6
 (HP) (yield gpm)
P.C.
 (type power)
- (7) electric log _____
 (yes or no)

 (organization running log)
- (8) how well bottom plugged wood


CODED

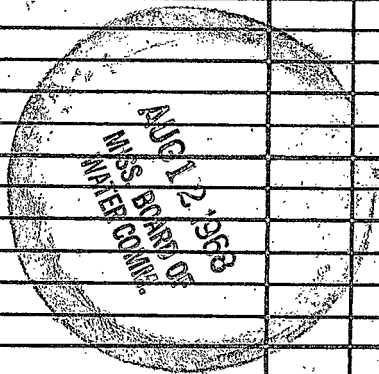

DRILLERS REMARKS:

If well telescopes please sketch and show depths.

GROUND LEVEL

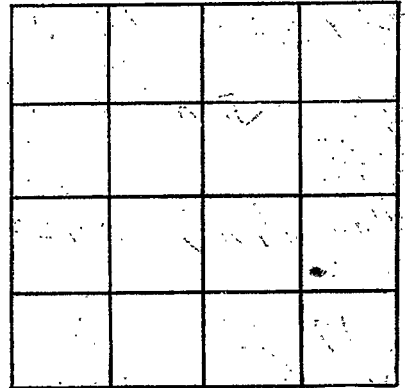

SECTION 12

Please indicate well location X.

ADDITIONAL INFORMATION

If more than one screen, show locations of each on sketch.