

Pike
G 38
8-68

CODED

MISSISSIPPI
BOARD OF WATER COMMISSIONERS
416 North State Street
Jackson, Mississippi 39201

WATER WELL DRILLERS LOG

Aug. 1 1968 J. T. Covington Pike
date well completed firm name county well located

LANDOWNER: Martin Garner

description of formations encountered from to

McComb, Miss
(mailing address)

clay 0 30
SPNC & Barks 30 85

WELL LOCATION:

sec 6 T 2 N R 7 E
12 miles West of McComb
(distance) (direction) (nearest town)

WELL PURPOSE: Home
(home, irrigation, municipal, industrial)

WELL COMPLETION DATA:

(1) diameter (inches) 4"

(2) total depth (feet) 85'

(3) static water level (feet) 55' below top of ground.

(4) casing Plastic, 79'
(material) (depth)

4" if telescope see back.
(size)

(5) screen 6', 85'
(length) (depth to top)

4", Plastic
(size) (material)

(6) pump None
(HP) (yield gpm)


A.C.
(type power)

(7) electric log _____
(yes or no)

(organization running log)

(8) how well bottom plugged wood

CODED

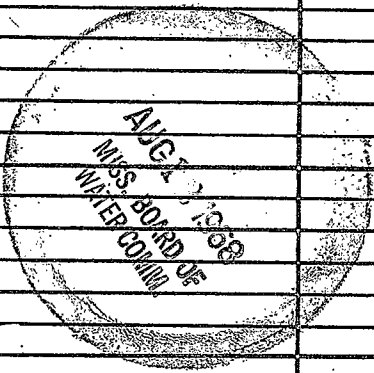

DRILLERS REMARKS:

If well telescopes please sketch and show depths.

GROUND LEVEL

SECTION

Please indicate well location X.

ADDITIONAL INFORMATION

If more than one screen, show locations of each on sketch.