

PIKE MISSISSIPPI BOARD OF WATER COMMISSIONERS

*Cancelled*  
1-15-68  
*Shannon*

~~G32~~ *cancel* **G39**  
1-7-66 ← WATER WELL DRILLERS LOG CODED

CODED

Date: 1-7, 1966, Driller: S. T. Covington Ben County Pike  
(Name)

- (1) Owner of Land: Rosa Richards  
(Name)  
Magnolia, Miss 1  
(Address)  
28, 217E  
(2) Location: 1/4, 1/4, Sec. 26, T 2 R 2E  
5 miles S/W of Magnolia  
(distance) (direction) (Nearest Town)  
(3) Topography: Hilly  
(Hilly) (Flat) (Level)  
(4) Purpose of Well: Domestic  
(Domestic Irrigation  
Municipal, Industrial, Other)


Description & Color of Materials Sand, Clay, Red Clay, Shell, etc.	Thick- ness Feet	Depth Feet
<u>Sandy Clay</u>	<u>30</u>	<u>30</u>
<u>Sand + Rock</u>	<u>30</u>	<u>60</u>
<u>Rock + sand</u>	<u>11</u>	<u>71</u>

Information upon completion of well:

- (1) Diameter 4" inches.  
(2) Total Depth 71' feet.  
(3) Water Level 55' feet below top of ground.  
(4) Cased to 71', Size 4"  
(5) Screen: Size 4", Length 6'  
(6) Were any formations sealed against pollution?  
no yes,  no.

If YES depth of formation \_\_\_\_\_  
Why \_\_\_\_\_  
Drillers Remarks: \_\_\_\_\_

*not coded*  
~~\_\_\_\_\_~~  
*Cannot locate*  
*RM*

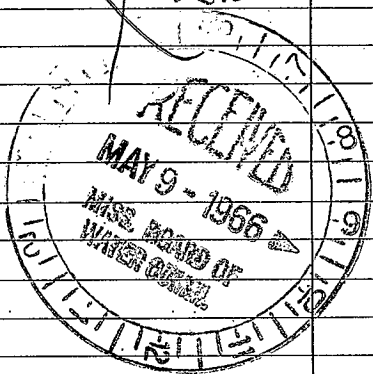

(Use Back Side)

Well No.

100

101

102

200