

CODED

Pike
G40
8-68

MISSISSIPPI  
BOARD OF WATER COMMISSIONERS  
416 North State Street  
Jackson, Mississippi 39201

WATER WELL DRILLERS LOG

Aug 22 1968 Reeves Well Drilling Co. Pike  
date well completed firm name county well located

LANDOWNER: David  
Whittington  
Rt-2, Magnolia  
(mailing address)

description of formations encountered	from	to
	yellow clay	0
gray chalk	16	21
pea gravel sand	21	24
red chalk	24	52
pea gravel sand	52	62

WELL LOCATION:  
sec. 15 T. 2 N. R. 7 E  
2 miles SW of Magnolia  
(distance) (direction) (nearest town)

WELL PURPOSE: home  
(home, irrigation, municipal, industrial)

- WELL COMPLETION DATA:
- (1) diameter (inches) 4"
  - (2) total depth (feet) 62
  - (3) static water level (feet) 20 below top of ground.
  - (4) casing plastic bottom  
(material) (depth)


- If telescope see back.
- (5) screen 6' 56'  
(length) (depth to top)
  - 4" plastic  
(size) (material)

- (6) pump ump installed  
(HP) (yield gpm)  
by owner
- (type power)

- (7) electric log no  
(yes or no)
- (organization running log)


- (8) how well bottom plugged wooden plug

DRILLERS REMARKS: old well dry.

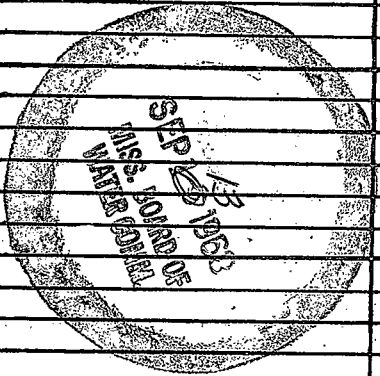

If well telescopes please sketch and show depths.

GROUND LEVEL

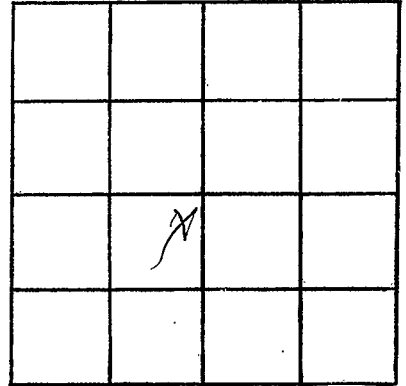

SECTION 15

Please indicate well location X.

ADDITIONAL INFORMATION

If more than one screen,  
show locations of each on sketch.