

CODED

MISSISSIPPI
BOARD OF WATER COMMISSIONERS
416 North State Street
Jackson, Mississippi 39201

WATER WELL DRILLERS LOG

<i>Pike</i>
<i>641</i>
<i>8-68</i>

Aug 26 19*68* *Reeves Well Drilling Co.* *Pike*
 date well completed firm name county well located

LANDOWNER: *Lucie M. Lamb*

Magnolia Miss
(mailing address)

WELL LOCATION:
 sec. *13* T. *2* N. R. *7* E.
3/4 miles *SE* of *Magnolia*
 (distance) (direction) (nearest town)

WELL PURPOSE:
(home, irrigation, municipal, industrial)

WELL COMPLETION DATA:


- (1) diameter (inches) *4"*
- (2) total depth (feet) *68*
- (3) static water level (feet) *51* below above top of ground.
- (4) casing *Plastic below*
(material) (depth)
- _____ if telescope see back.
(size)
- (5) screen *6'* *62'*
(length) (depth to top)
- 4"* *plastic*
(size) (material)
- (6) pump *1/2 sub-17*
(HP) (yield gpm)
- elect*
(type power)
- (7) electric log *no*
(yes or no)

_____ (organization running log)

(8) how well bottom plugged
water plug


DRILLERS REMARKS:
New House -

description of formations encountered	from	to
<i>Red clay</i>	<i>0</i>	<i>18</i>
<i>sand & gravel</i>	<i>18</i>	<i>50</i>
<i>sand</i>	<i>50</i>	<i>60</i>
<i>Reagravel & sand</i>	<i>60</i>	<i>68</i>

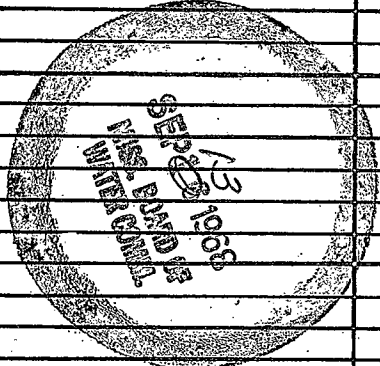

If well telescopes please sketch and show depths.

GROUND LEVEL

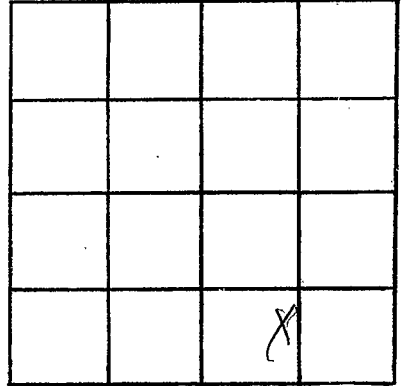

SECTION 13

Please indicate well location X.

ADDITIONAL INFORMATION

If more than one screen,
show locations of each on sketch.