

CODED

Pike
G 42
12-19-68

MISSISSIPPI
BOARD OF WATER COMMISSIONERS
416 North State Street
Jackson, Mississippi 39201

CODED

WATER WELL DRILLERS LOG

Dec 19 1968 date well completed
Fitzgibbon Bros firm name
Pike county well located

LANDOWNER:
Blades
R.R. Magnolia Miss.
(mailing address)

description of formations encountered	from	to
Red clay	6	20
Red sand	20	70
Red gravel	70	76
Red clay	76	90
Red sand	90	130
Coarse sand & gravel	130	140

WELL LOCATION:
sec. 31 T. 2 N R. 7 E
6 miles SW of Magnolia
(distance) (direction) (nearest town)

WELL PURPOSE:
(home, irrigation, municipal, industrial)

WELL COMPLETION DATA:

(1) diameter (inches) 4"

(2) total depth (feet) 140

(3) static water level (feet) 50 below top of ground.

(4) casing Plastic, 134,
(material) (depth)
4 if telescope see back.
(size)

(5) screen 6, 134
(length) (depth to top)
24", Plastic
(size) (material)

(6) pump 1/2, 10
(HP) (yield gpm)
Electric
(type power)

(7) electric log no
(yes or no)
(organization running log)

(8) how well bottom plugged usual per


CODED

DRILLERS REMARKS:

MISSISSIPPI
STATE
WATER
BOARD

If well telescopes please sketch and show depths.

GROUND LEVEL

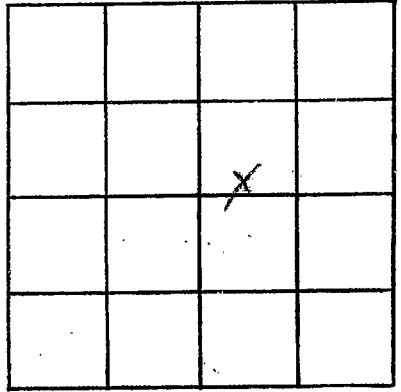

SECTION 31

Please indicate well location X.

ADDITIONAL INFORMATION

If more than one screen,
show locations of each on sketch.