

CODED

MISSISSIPPI
BOARD OF WATER COMMISSIONERS
416 North State Street
Jackson, Mississippi 39201

CODED

WATER WELL DRILLERS LOG

Nov. 22
date well completed

1968 J. Treawington
firm name

Pike
county well located

LANDOWNER: Don Burton

description of formations encountered	from	to

Magnolia Miss
(mailing address)

2 1/2 y SAND & ROCKS	0 feet	107 feet
-------------------------	-----------	-------------

WELL LOCATION:
sec 14 T 2 N R 7 E
S W
7 miles west of Magnolia
(distance) (direction) (nearest town)

WELL PURPOSE: Home
(home, irrigation, municipal, industrial)

WELL COMPLETION DATA:

- (1) diameter (inches) 16"
- (2) total depth (feet) 107'
- (3) static water level (feet) 80' below above top of ground.
- (4) casing Plastic, 101'
(material) (depth)
" If telescope see back.
(size)
- (5) screen 6", 107'
(length) (depth to top)
4", Plastic
(size) (material)
- (6) pump Bucket
(HP) (yield gpm)

(type power)
- (7) electric log _____
(yes or no)


(organization running log)
- (8) how well bottom plugged wood

DRILLERS REMARKS:

DEC 29 1968
MISS. DEPT. OF
WATER RESOURCES

If well telescopes please sketch and show depths.

GROUND LEVEL

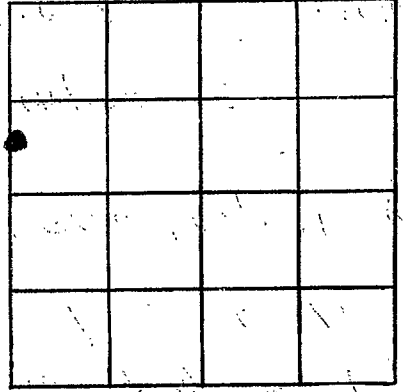

SECTION 18

Please indicate well location X.

ADDITIONAL INFORMATION

If more than one screen, show locations of each on sketch.