

CODED

MISSISSIPPI  
BOARD OF WATER COMMISSIONERS  
416 North State Street  
Jackson, Mississippi 39201

CODED

WATER WELL DRILLERS LOG

1-22-69 date well completed  
1969 Fitzgerald Water Well firm name  
Dike county well located

LANDOWNER: Joe Jackson

Rt Magnolia Miss

(mailing address)

WELL LOCATION:

sec. 14 T 2 N R 7 E  
S W  
1 miles SW of Magnolia  
(distance) (direction) (nearest town)

WELL PURPOSE: HOME  
(home, irrigation, municipal, industrial)

WELL COMPLETION DATA:

- (1) diameter (inches) 4
- (2) total depth (feet) 122
- (3) static water level (feet) 80 below top of ground.
- (4) casing Plastic 116 (material) (depth)  
4 (size) if telescope see back.
- (5) screen 6 116 (length) (depth to top)  
4 (size) Plastic (material)
- (6) pump 1/2 10 (HP) (yield gpm)  
Electric (type power)
- (7) electric log no (yes or no)
- (organization running log)
- (8) how well bottom plugged Chisel

description of formations encountered

from to

Red clay	0	10
Red gravel	10	60
Red sand	60	90
Coarse sand & gravel	90	106
Red sand	106	110
Coarse sand & gravel	110	122

CODED


FEB 13 1969

MISS. DEPT. OF WATER CONTROL

DRILLERS REMARKS:

If well telescopes please sketch and show depths.

GROUND LEVEL

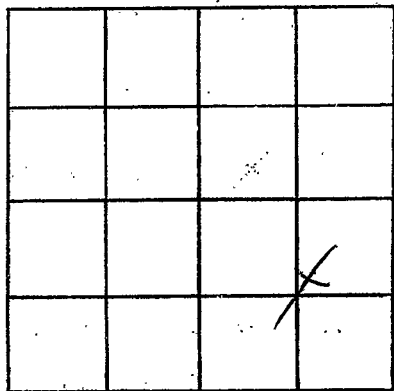

SECTION 14

Please indicate well location X.

ADDITIONAL INFORMATION

If more than one screen,  
show locations of each on sketch.