

CODED

Pike  
HAT  
2-11-69

MISSISSIPPI  
BOARD OF WATER COMMISSIONERS  
416 North State Street  
Jackson, Mississippi 39201

CODED

WATER WELL DRILLERS LOG

Feb 11 1969 J. T. Carrington Pike  
date well completed firm name county well located

LANDOWNER: Harvey Temple

| description of formations encountered | from | to  |
|---------------------------------------|------|-----|
| Silt & Sand                           | 0    | 20  |
| SAND & GRAVEL                         | 20   | 109 |

Magnolia, Miss.  
(mailing address)

WELL LOCATION:  
sec 21 T 2 N R 7 E  
S W  
4 miles West of Magnolia  
(distance) (direction) (nearest town)

WELL PURPOSE: Home  
(home, irrigation, municipal, industrial)

- WELL COMPLETION DATA:
- (1) diameter (inches) 4"
  - (2) total depth (feet) 109'
  - (3) static water level (feet) 80' below above top of ground.
  - (4) casing Plastic, 103'  
(material) (depth)  
(size) If telescope see back.
  - (5) screen 6", 109'  
(length) (depth to top)  
4", Plastic  
(size) (material)
  - (6) pump 1/2, 8  
(HP) (yield gpm)  
A.C.  
(type power)
  - (7) electric log \_\_\_\_\_  
(yes or no)
  - (organization running log)
  - (8) how well bottom plugged wood


FEB 18 1969

MISS. Bd. OF  
WATER COMMISSIONERS

DRILLERS REMARKS:

If well telescopes please sketch and show depths.

GROUND LEVEL

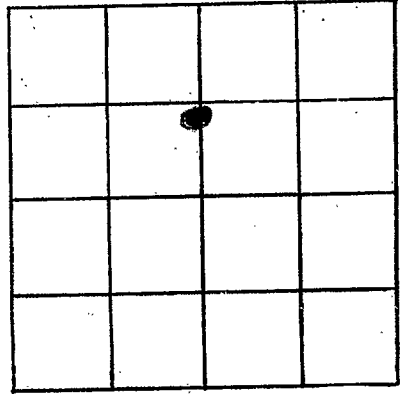

SECTION 21

Please indicate well location X.

ADDITIONAL INFORMATION

If more than one screen, show locations of each on sketch.