

CODED

Pike
G48
2-28-69

MISSISSIPPI
BOARD OF WATER COMMISSIONERS
416 North State Street
Jackson, Mississippi 39201

CODED

CODED

WATER WELL DRILLERS LOG

Feb 28 1969 date well completed
Fitzgerald well drill firm name
Pike county well located

LANDOWNER:

Sill Monosmith

Rh. Magnolia, Miss.
(mailing address)

WELL LOCATION:

sec. 25 T. 2 N. R. 7 E.
S W
2 miles S of Magnolia
(distance) (direction) (nearest town)

WELL PURPOSE:

Home
(home, irrigation, municipal, industrial)

WELL COMPLETION DATA:

- (1) diameter (inches) 4
- (2) total depth (feet) 100
- (3) static water level (feet) 65 below above top of ground.
- (4) casing plastic 94 (material) (depth)
4 (size) if telescope see back.
- (5) screen 6 94 (length) (depth to top)
4 plastic (material)
- (6) pump 3/4 25 (HP) (yield gpm)
Glee (type power)
- (7) electric log No (yes or no)
(organization running log)
- (8) how well bottom plugged completely

description of formations encountered

from to

Red Clay	0	15
Red Sand	15	60
Red Sand & gravel	60	85
Coarse Sand & gravel	85	100

PLUGGED


MAR 13 1969
MAR 1

MISS. BD. OF
WATER COMMISSIONERS

DRILLERS REMARKS:

If well telescopes please sketch and show depths.

GROUND LEVEL

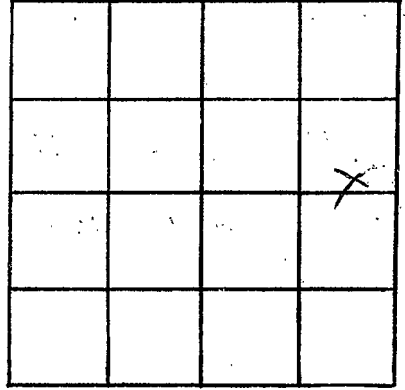

SECTION 25

Please indicate well location X.

ADDITIONAL INFORMATION

If more than one screen, show locations of each on sketch.