

Dike
G 49
5-12-69

MISSISSIPPI
 BOARD OF WATER COMMISSIONERS
 416 North State Street
 Jackson, Mississippi 39201

CODED

WATER WELL DRILLERS LOG

5-12 1969 Fitzgerald Dike
 date well completed firm name county well located

LANDOWNER:
J. D. Easter
RR Progress, Miss.
 (mailing address)

description of formations encountered	from	to
<u>Red clay</u>	<u>6</u>	<u>20</u>
<u>Red sand</u>	<u>20</u>	<u>80</u>
<u>Coarse sand & gravel</u>	<u>80</u>	<u>101</u>

WELL LOCATION:
 sec. 25 T. 2 N R. 7 E
 S W
4 miles S of Magnolia
 (distance) (direction) (nearest town)

WELL PURPOSE: Home
 (home, irrigation, municipal, industrial)

CODED

- WELL COMPLETION DATA:
- (1) diameter (inches) 4
 - (2) total depth (feet) 101
 - (3) static water level (feet) 65 below above top of ground.
 - (4) casing Plastic, 95,
 (material) (depth)
4 if telescope see back.
 (size)
 - (5) screen 6, 95
 (length) (depth to top)
4, Plastic
 (size) (material)
 - (6) pump ?, ?
 (HP) (yield gpm)
P
 (type power)
 - (7) electric log No
 (yes or no)
 - (organization running log)
 - (8) how well bottom plugged shut off


DRILLERS REMARKS:

JUN 2 - 1969

MISS. BD. OF
 WATER COMM.

If well telescopes please sketch and show depths.

GROUND LEVEL

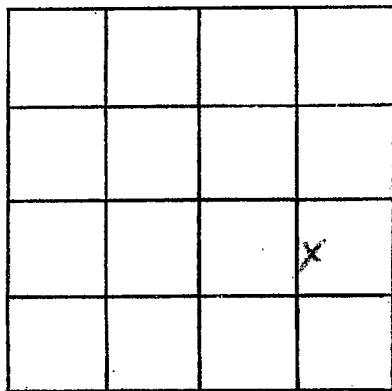

SECTION 25

Please indicate well location X.

ADDITIONAL INFORMATION

If more than one screen, show locations of each on sketch.