

Pike Co
 G 51
 3-5-70

MISSISSIPPI
 BOARD OF WATER COMMISSIONERS
 416 North State Street
 Jackson, Mississippi 39201

CODED

WATER WELL DRILLERS LOG

3-5 1970 To Fitzgerald Sew firm name Pike county well located

LANDOWNER:
Randolph Teroin
R.R. Magnolia, Miss.
 (mailing address)

| description of formations encountered | from | to |
|---------------------------------------|------|-----|
| Real Clay | 0 | 25 |
| Real Sand | 25 | 75 |
| Real gravel | 75 | 90 |
| Real sand | 90 | 110 |
| Coarse sand & gravel | 110 | 120 |

WELL LOCATION:
 sec. 27 T-2 N R-7 E
2 miles SW of Magnolia
 (distance) (direction) (nearest town)

WELL PURPOSE: Home
 (home, irrigation, municipal, industrial)

WELL COMPLETION DATA:

(1) diameter (inches) 4

(2) total depth (feet) 120

(3) static water level (feet) 80 below top of ground.

(4) casing Plastic, 112 (material) (depth)
4 if telescope see back. (size)

(5) screen 8, 112 (length) (depth to top)
4, Plastic (size) (material)

(6) pump 1/2, 10 (HP) (yield gpm)
Elm (type power)

(7) electric log no (yes or no)
no (organization running log)

(8) how well bottom plugged covered log

CODED


MAR 16 1970

MISS. BD. OF
 WATER COMMI.

DRILLERS REMARKS:

If well telescopes please sketch and show depths.

GROUND LEVEL

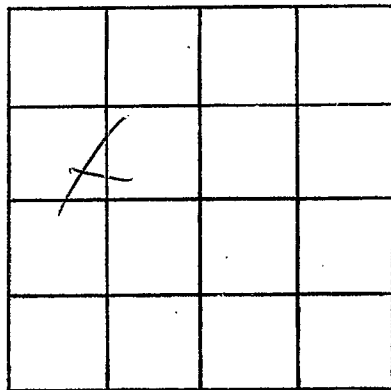

SECTION 27

Please indicate well location X.

ADDITIONAL INFORMATION

If more than one screen,
show locations of each on sketch.