

Pike Co
 G 52
 3-17-70

MISSISSIPPI
 BOARD OF WATER COMMISSIONERS
 416 North State Street
 Jackson, Mississippi 39201

WATER WELL DRILLERS LOG

3-17
 date well completed

1970 *Fitzgerald Well Drilling Co*
 firm name

COPIED
 county well located

LANDOWNER:
Sam Jones
RR Magnolia, Miss
 (mailing address)

description of formations encountered	from	to
<i>Red Clay</i>	0	45
<i>Red Sand</i>	45	55
<i>Red gravel</i>	55	63
<i>Red Sand</i>	63	75
<i>Red gravel</i>	75	88
<i>Red Chalk</i>	88	100
<i>White Sand gravel</i>	100	122

WELL LOCATION:
 sec. *18* T. *2* N R. *7* E *MR*
6 miles *W* of *Magnolia*
 (distance) (direction) (nearest town)

WELL PURPOSE: *Home*
 (home, irrigation, municipal, industrial)

WELL COMPLETION DATA:

(1) diameter (inches) *4*

(2) total depth (feet) *122*

(3) static water level (feet) *95* below above top of ground.

(4) casing *flexible 1 1/2*,
 (material) (depth)
4 if telescope see back.
 (size)

(5) screen *6*, *1 1/2*
 (length) (depth to top)
4, *flexible*
 (size) (material)

(6) pump *1*, *7*
 (HP) (yield gpm)
Ele
 (type power)

(7) electric log *no*
 (yes or no)
 (organization running log)

(8) how well bottom plugged *covered*


COPIED

APR - 6 1970

DRILLERS REMARKS:

If well telescopes please sketch and show depths.

GROUND LEVEL

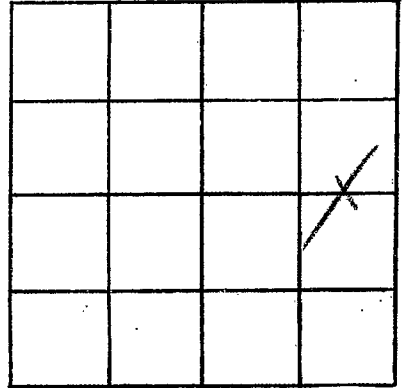

SECTION 18

Please indicate well location X.

ADDITIONAL INFORMATION

If more than one screen, show locations of each on sketch.