

Pike Co
 G 53
 4-7-70

MISSISSIPPI
 BOARD OF WATER COMMISSIONERS
 416 North State Street
 Jackson, Mississippi 39201

CODED

WATER WELL DRILLERS LOG

Apr 7 1970 To Fitzgerald well for Pike
 date well completed firm name county well located

LANDOWNER:

Carie Andrews
 R.R. Magnolia
 (mailing address)

description of formations encountered

from to

red clay	0	20
red sand	20	80
Coarse sand & gravel	80	124

WELL LOCATION:

sec. 25 T. 2N R. 7 E
 4 miles SSE of Magnolia
 (distance) (direction) (nearest town)

WELL PURPOSE:

Home
 (home, irrigation, municipal, industrial)

WELL COMPLETION DATA:

- (1) diameter (inches) 4
- (2) total depth (feet) 124
- (3) static water level (feet) 94 below above top of ground.
- (4) casing plaster 118 (material) (depth)
 4 (size) If telescope see back.
- (5) screen 6 118 (length) (depth to top)
 4 (size) plaster (material)
- (6) pump 3/4 6 (HP) (yield gpm)
 Eli (type power)
- (7) electric log no (yes or no)
 (organization running log)
- (8) how well bottom plugged wool

CODED


APR 29 1970

DRILLERS REMARKS:

MISS. BD. OF
 WATER COMM.

If well telescopes please sketch and show depths.

GROUND LEVEL

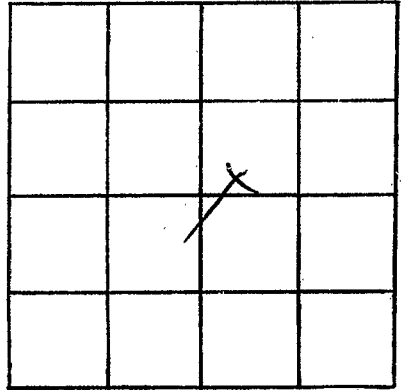

SECTION 25

Please indicate well location X.

ADDITIONAL INFORMATION

If more than one screen,
show locations of each on sketch.