

Pike Co
 G 54
 4-7-70

MISSISSIPPI
 BOARD OF WATER COMMISSIONERS
 416 North State Street
 Jackson, Mississippi 39201

WATER WELL DRILLERS LOG

April 9 1970 Chester Keener Pike
 date well completed firm name county well located

LANDOWNER: Dr. G. V. Beacham
 Magnolia

(mailing address)

WELL LOCATION:
 sec 23 T 20 R 7 E 065
 1 1/2 miles S of Magnolia
 (distance) (direction) (nearest town)

WELL PURPOSE: Same
 (home, irrigation, municipal, industrial)

WELL COMPLETION DATA:

- (1) diameter (inches) 2 1/2
- (2) total depth (feet) 235
- (3) static water level (feet) 10 below above top of ground.
- (4) casing galv. bottom (material) (depth)
- (size) if telescope see back.
- (5) screen 15' 220' (length) (depth to top)
 1 1/2" Plastic (size) (material)
- (6) pump None (HP) (yield gpm)
 (type power)
- (7) electric log NO (yes or no)
 (organization running log)
- (8) how well bottom plugged
 Screen


description of formations encountered	depth	
	from	to
clay	0	17
Sand	17	27
Sand & gravel	27	46
white chalk	46	187
fine white sand	187	220
coarse sand	220	235

DRILLERS REMARKS:
 Previous well
 Sanded

MAY 14 1970
 MISS. Bd. OF
 WATER COMMISSIONERS

If well telescopes please sketch and show depths.

GROUND LEVEL

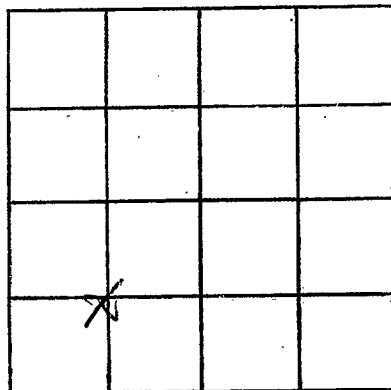

SECTION 23

Please indicate well location X.

ADDITIONAL INFORMATION.

If more than one screen,
show locations of each on sketch.