

Pike
 G 55
 5-11-70

MISSISSIPPI
 BOARD OF WATER COMMISSIONERS
 416 North State Street
 Jackson, Mississippi 39201

WATER WELL DRILLERS LOG

May 11 1970 day well completed
 Fidelity Well Drilling firm name
 Pike county well located

LANDOWNER:
 Elton Lewis
 P.O. Magnolia Miss.
 (mailing address)

description of formations encountered	from to	
	feet	feet
Red Clay	0	15
Red Sand	15	75
Red gravel	75	90
Coarse sand & gravel	90	107

WELL LOCATION:
 sec. 3 T. 2 N. R. 7 E. 029
 3 miles SE of P.O. Park
 (distance) (direction) (nearest town)

WELL PURPOSE:
 (home, irrigation, municipal, industrial)

WELL COMPLETION DATA:

(1) diameter (inches) 4
 (2) total depth (feet) 75
 (3) static water level (feet) 10 below top of ground.
 (4) casing (material) plastic (depth) 99
 (size) 4 if telescope see back.
 (5) screen (length) 8 (depth to top) 99
 (size) 4 (material) plastic
 (6) pump (HP) 1/2 (yield gpm) 10
 (type power) elec
 (7) electric log no (yes or no)
 (organization running log)


(8) how well bottom plugged
 (signature)

DRILLERS REMARKS:

MAY 28 1970
 MISS. BD. OF WATER COMMISSIONERS

If well telescopes please sketch and show depths.

GROUND LEVEL

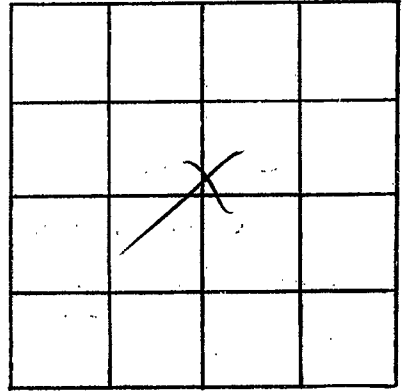

SECTION 3

Please indicate well location X.

ADDITIONAL INFORMATION

If more than one screen,
show locations of each on sketch.