

Pike
G58
5-28-70

MISSISSIPPI
BOARD OF WATER COMMISSIONER
416 North State Street
Jackson, Mississippi 39201

CODED

WATER WELL DRILLERS LOG

5-28 date well completed 1970 To Fitzgerald Well Co firm name Pike county well located

LANDOWNER:
Lillie Mager
R.R. Magnolia, Miss.
(mailing address)

description of formations encountered	from	to
Red Clay	0	20
Red Sand	20	74
Coarse sand & gravel	74	83

WELL LOCATION:
sec. 15 T 20 N R 7 E
2 miles W of Magnolia
(distance) (direction) (nearest town)

WELL PURPOSE: domestic
(home, irrigation, municipal, industrial)

- WELL COMPLETION DATA:
- (1) diameter (inches) 4
 - (2) total depth (feet) 83
 - (3) static water level (feet) 50 below top of ground.
 - (4) casing Plastic 75
(material) (depth)
4 if telescope see back.
(size)
 - (5) screen 8 75
(length) (depth to top)
4 Plastic
(size) (material)
 - (6) pump 3/4 6
(HP) (yield gpm)
elm
(type power)
 - (7) electric log no
(yes or no)
 - (organization running log)
 - (8) how well bottom plugged wood peg

CODED


JUN 29 1970

DRILLERS REMARKS:

MISS. BD. OF
WATER COMM.

If well telescopes please sketch and show depths.

GROUND LEVEL

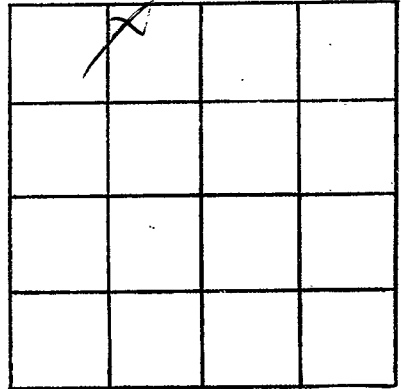

SECTION 15

Please indicate well location X.

ADDITIONAL INFORMATION

If more than one screen, show locations of each on sketch.