

Pike
G-59
5-28-70

MISSISSIPPI
BOARD OF WATER COMMISSIONERS
416 North State Street
Jackson, Mississippi 39201

CODED

WATER WELL DRILLERS LOG

May 28 1970 Chester Kerue Pike-
date well completed firm name county well located

LANDOWNER: Jack Harwood
Rt 2, Mapaha

description of formations encountered	from	to
	<u>chack</u>	<u>0</u>
<u>sand & gravel</u>	<u>10</u>	<u>14 1/2</u>

(mailing address)

WELL LOCATION:

sec. 15 T. 20 N. R. 7 E.
1 1/2 miles SW of Mapaha
(distance) (direction) (nearest town)

WELL PURPOSE: home
(home, irrigation, municipal, industrial)

WELL COMPLETION DATA:

- (1) diameter (inches) 4"
- (2) total depth (feet) 4'
- (3) static water level (feet) 10 below above top of ground.
- (4) casing Plastic (material) 14' (depth)

if telescope see back, (size)

- (5) screen 6' (length) 3.5' (depth to top)
1/2" (size) Plastic (material)

- (6) pump summers addump (HP) (yield gpm)
2200 (type power)

- (7) electric log No (yes or no)

(organization running log)

- (8) how well bottom plugged gravel

DRILLERS REMARKS:
old well had


CODED

JUL 27 1970

MISS. BD. OF
WATER COMMISSIONERS

If well telescopes please sketch and show depths.

GROUND LEVEL

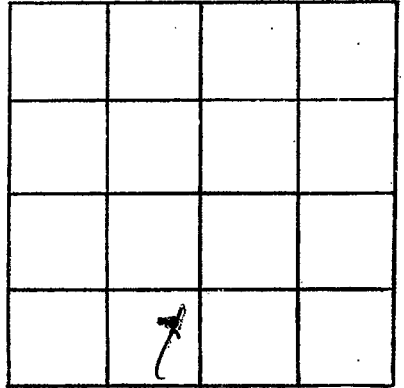

SECTION 15

Please indicate well location X.

ADDITIONAL INFORMATION

If more than one screen,
show locations of each on sketch.