

Pike  
G 60  
6-4-70

MISSISSIPPI  
BOARD OF WATER COMMISSIONERS  
416 North State Street  
Jackson, Mississippi 39201

**CODED**

WATER WELL DRILLERS LOG

6-4-70 date well completed 1970 firm name *Fitzgerald Well Serv* county well located *Pike*

LANDOWNER:  
*Shawn Estes*  
*R.R. Magnolia Mines*  
(mailing address)

description of formations encountered	from	to
<i>Red clay</i>	<i>0</i>	<i>20</i>
<i>Red sand</i>	<i>20</i>	<i>80</i>
<i>Red gravel</i>	<i>80</i>	<i>100</i>
<i>Coarse sand &amp; gravel</i>	<i>100</i>	<i>112</i>

WELL LOCATION:  
sec. *24* T *2* N R *7* E  
*1* miles *E* of *Magnolia*  
(distance) (direction) (nearest town)

WELL PURPOSE: *Home*  
(home, irrigation, municipal, industrial)

- WELL COMPLETION DATA:
- (1) diameter (inches) 4
  - (2) total depth (feet) 112
  - (3) static water level (feet) 80 below top of ground.
  - (4) casing plastic, 104,  
(material) (depth)  
4 if telescope see back.  
(size)
  - (5) screen 8, 104  
(length) (depth to top)  
4, plastic  
(size) (material)
  - (6) pump 1 1/2, 10  
(HP) (yield gpm)  
Electric  
(type power)
  - (7) electric log no  
(yes or no)  
(organization running log)
  - (8) how well bottom plugged as well as possible

**CODED**


DRILLERS REMARKS:

JUN 29 1970

MISS. BD. OF  
WATER COMM.

If well telescopes please sketch and show depths.

GROUND LEVEL

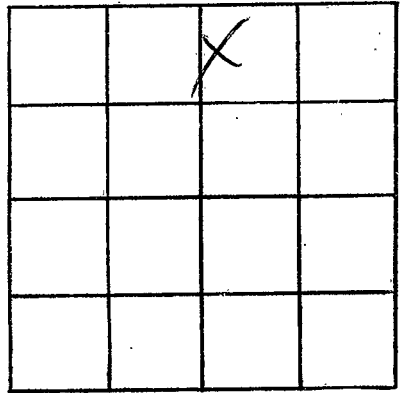

SECTION 24

Please indicate well location X.

ADDITIONAL INFORMATION

If more than one screen,  
show locations of each on sketch.