

PIKE
G63
9-21-70

MISSISSIPPI
BOARD OF WATER COMMISSIONERS
416 North State Street
Jackson, Mississippi 39201

CODED

WATER WELL DRILLERS LOG

Sept 21, 1970 Chester Keener Pike
date well completed firm name county well located

LANDOWNER: Charles
Earley
W.D. Mapaha
(mailing address)

WELL LOCATION:
sec. 25 T 2 N R 7 E
2 1/2 miles SSE Mapaha
(distance) (direction) (nearest town)

WELL PURPOSE: Home - Down
(home, irrigation, municipal, industrial)

WELL COMPLETION DATA:

- (1) diameter (inches) 4"
- (2) total depth (feet) 48
- (3) static water level (feet) 58 below above top of ground.
- (4) casing Plastic ball joint
(material) (depth)
- (size) if telescope see back.
- (5) screen 6' 82
(length) (depth to top)
- 4" Plastic
(size) (material)
- (6) pump 3/4 Sub 15
(HP) (yield gpm)
- Elect
(type power)
- (7) electric log NO
(yes or no)

(organization running log)

(8) how well bottom plugged wooden plug

DRILLERS REMARKS:
old 2" well had

description of formations encountered	from	to
Red clay	0	15
Red sandy clay	15	52
Sand & gravel	52	67
Blue chalk	67	74
Small gravel sand	74	88


CODED

NOV 12 1970

MISSISSIPPI BOARD OF WATER COMMISSIONERS

If well telescopes please sketch and show depths.

GROUND LEVEL

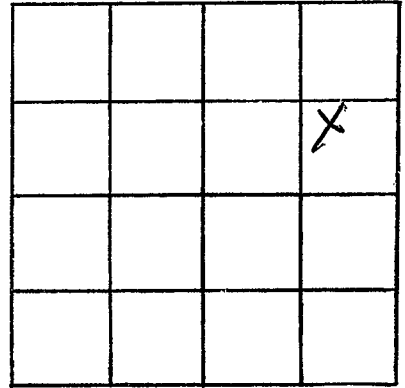

SECTION 25

Please indicate well location X.

ADDITIONAL INFORMATION

If more than one screen,
show locations of each on sketch.