

PIKE
G64
9-25-70

MISSISSIPPI
BOARD OF WATER COMMISSIONERS
416 North State Street
Jackson, Mississippi 39201

CODED

WATER WELL DRILLERS LOG

Sept 25 1970 J.V. Covington & Son Pipe
date well completed firm name county well located

LANDOWNER: ~~Jimmy~~
Jimmy Brumfield
Magnolia, Miss.
(mailing address)

description of formations encountered	depth	
	from	to
Clay	0	20
Chalk	20	60
Sand & gravel	60	91

WELL LOCATION:
sec. 36 T. 2 N R. 7 E
8 miles south of Magnolia
(distance) (direction) (nearest town)

WELL PURPOSE: Home
(home, irrigation, municipal, industrial)

- WELL COMPLETION DATA:
- (1) diameter (inches) 4"
 - (2) total depth (feet) 91
 - (3) static water level (feet) 60 below top of ground
 - (4) casing (material) pl (depth) 91 (size) if telescope see back.
 - (5) screen (length) 6' (depth to top) 91 (size) pl (material)
 - (6) pump (HP) 1/2 (yield gpm) 14 (type power) Elbit
 - (7) electric log (yes or no) No
 - (organization running log)
 - (8) how well bottom plugged wood

CODED


DEC 11 1970

DRILLERS REMARKS:

MISS. DIV. OF WATER CONTROL

If well telescopes please sketch and show depths.

GROUND LEVEL

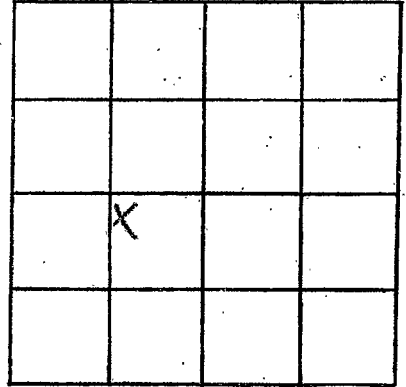

SECTION 36

Please indicate well location X.

ADDITIONAL INFORMATION

If more than one screen, show locations of each on sketch.