

MISSISSIPPI
 BOARD OF WATER COMMISSIONERS
 416 North State Street
 Jackson, Mississippi 39201

CODED

WATER WELL DRILLERS LOG

PIKE
G 65
11-14-70

14 Nov 1970 S&P Water Well Co. Pike
 date well completed firm name county well located

LANDOWNER:
Henry Vick
May
 (mailing address)

description of formations encountered	from	to
clay	0	20
brn. chert	20	40
sand shell	40	65
chert sand	65	85
chert	85	160
sand	160	192

WELL LOCATION:
 sec. 15 T. 2 N. R. 7 E
3 miles West of May
 (distance) (direction) (nearest town)

WELL PURPOSE:
 (home, irrigation, municipal, industrial)

- WELL COMPLETION DATA:
- (1) diameter (inches) 4
 - (2) total depth (feet) 192
 - (3) static water level (feet) 90 below above top of ground.
 - (4) casing PI 186
 (material) (depth)
 (size) if telescope see back.
 - (5) screen 6 186
 (length) (depth to top)
4 PI
 (size) (material)
 - (6) pump 1 8
 (HP) (yield gpm)
elect
 (type power)
 - (7) electric log
 (yes or no)

CODED

(organization running log)

JAN 17 1971


(8) how well bottom plugged wood

MISS. Bd. of
 WATER COMMISSIONERS

DRILLERS REMARKS:

If well telescopes please sketch and show depths.

GROUND LEVEL

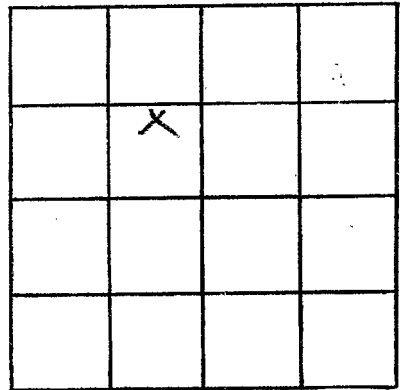

SECTION 15

Please indicate well location X.

ADDITIONAL INFORMATION

If more than one screen, show locations of each on sketch.