

MISSISSIPPI
BOARD OF WATER COMMISSIONERS
416 North State Street
Jackson, Mississippi 39201

CODED

WATER WELL DRILLERS LOG

PIKE
G 660
11-30-70

30 Nov 70 date well completed SKP Waterwell firm name Pike county well located

LANDOWNER: Les Brown
Ogden
(mailing address)

description of formations encountered	from	to
<u>clay</u>	<u>0</u>	<u>25</u>
<u>chert clay</u>	<u>25</u>	<u>40</u>
<u>sand & chert</u>	<u>40</u>	<u>55</u>
<u>sand</u>	<u>55</u>	<u>80</u>
<u>chert sand</u>	<u>80</u>	<u>95</u>
<u>sand</u>	<u>95</u>	<u>133</u>

WELL LOCATION:
sec. 33 T 2 N R. 7 E
6 miles West of Mag.
(distance) (direction) (nearest town)

WELL PURPOSE:
(home, irrigation, municipal, industrial)

- WELL COMPLETION DATA:
- (1) diameter (inches) 4
 - (2) total depth (feet) 133
 - (3) static water level (feet) 85 below above top of ground.
 - (4) casing PI (177)
(material) (depth)
(size) if telescope see back.
 - (5) screen 6 (177)
(length) (depth to top)
4 (PI)
(size) (material)
 - (6) pump 1/2 (10)
(HP) (yield gpm)
elect
(type power)
 - (7) electric log
(yes or no)
(organization running log)
 - (8) how well bottom plugged wood

CODED


JAN 11 1971

MISS. BD. OF
WATER COMM.

DRILLERS REMARKS:

If well telescopes please sketch and show depths.

GROUND LEVEL

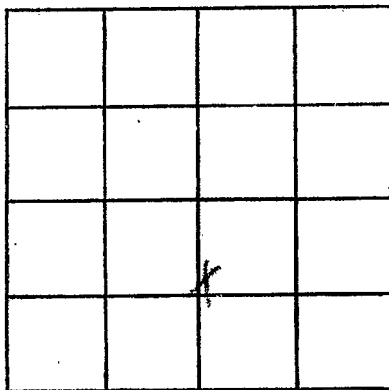

SECTION 33

Please indicate well location X.

ADDITIONAL INFORMATION

If more than one screen, show locations of each on sketch.