

MISSISSIPPI
BOARD OF WATER COMMISSIONERS
416 North State Street
Jackson, Mississippi 39201

CODED

WATER WELL DRILLERS LOG

PIKE
G67
11-19-70

Nov. 19 1970 Chester Keenes Pike
date well completed firm name county well located

LANDOWNER Shelton D. Dumas

description of formations encountered

from to

RTD
Magnolia
(mailing address)

Clay

0 10

Sand

10 60

Sand & gravel

60 80

chalk

80 95

Sand & gravel

95 114

WELL LOCATION:

sec. 4 T. 2 N. R. 1 E.
3 miles SW of Magnolia
(distance) (direction) (nearest town)

WELL PURPOSE: Home
(home, irrigation, municipal, industrial)

WELL COMPLETION DATA:

- (1) diameter (inches) 4"
- (2) total depth (feet) 114
- (3) static water level (feet) 97 below above top of ground.
- (4) casing Plastic Ballant
(material) (depth)
- (size) if telescope see back.
- (5) screen 6' 108
(length) (depth to top)
- 4" Plastic
(size) (material)
- (6) pump 1/2 hp 2
(HP) (yield gpm)
- Elect
(type power)
- (7) electric log No
(yes or no)

(organization running log)

(8) how well bottom plugged wooden plug

DRILLERS REMARKS: New house


CODED

FEB 5 1971

MISS. DD. 05
WATER COMMISSIONERS

If well telescopes please sketch and show depths.

GROUND LEVEL

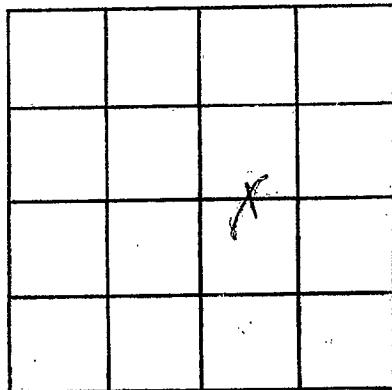

SECTION 4

Please indicate well location X.

ADDITIONAL INFORMATION

If more than one screen, show locations of each on sketch.