

MISSISSIPPI
BOARD OF WATER COMMISSIONERS
416 North State Street
Jackson, Mississippi 39201

CODED

WATER WELL DRILLERS LOG

Pike
G68
8-6-69

Aug 6 1969 date well completed Kelner Well Drilling firm name Pike county well located

LANDOWNER: M.C. Lewis
Mapala Rt 2

description of formations encountered	from	to
<u>Sandy clay gravel</u>	<u>0</u>	<u>16</u>
<u>Sandy gravel</u>	<u>16</u>	<u>28</u>
<u>White chalk</u>	<u>28</u>	<u>35</u>
<u>fine chally sand</u>	<u>35</u>	<u>70</u>
<u>Coarse sand</u>	<u>70</u>	<u>76</u>

(mailing address)

WELL LOCATION:

sec. 5 T 2 N R 7 E
1 1/2 miles SW of Mapala
(distance) (direction) (nearest town)

WELL PURPOSE: Home
(home, irrigation, municipal, industrial)

WELL COMPLETION DATA:

- (1) diameter (inches) 4"
- (2) total depth (feet) 76
- (3) static water level (feet) 21 below above top of ground
- (4) casing Plastic Ballou
(material) (depth)

(size) if telescope see back.

- (5) screen 6' 70'
(length) (depth to top)
4" plastic
(size) (material)
- (6) pump 1/2 HP 10
(HP) (yield gpm)
Electric
(type power)
- (7) electric log NO
(yes or no)

(organization running log)

- (8) how well bottom plugged wood plug

DRILLERS REMARKS: New location


CODED

SEP 20 1969

MISS. DE. GE
SUCCEEDS EXHIBIT

If well telescopes please sketch and show depths.

GROUND LEVEL

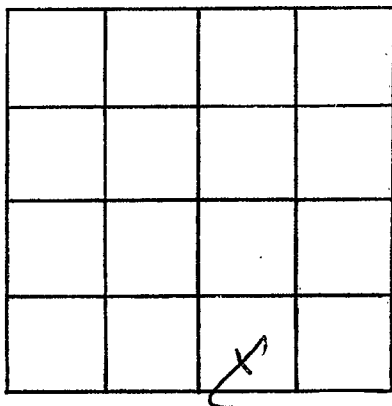

SECTION A

Please indicate well location X.

ADDITIONAL INFORMATION

If more than one screen,
show locations of each on sketch.