

MISSISSIPPI
BOARD OF WATER COMMISSIONERS
416 North State Street
Jackson, Mississippi 39201

CODED

WATER WELL DRILLERS LOG

Pike
G70
8-26-69

8-26
date well completed

1969

Fitzgerald
firm name

Pike
county well located

LANDOWNER:

John Brown
R.R. Magnolia, Miss.
(mailing address)

WELL LOCATION:

sec. 23 T 2 N R. 7 E W
1 miles SW of May
(distance) (direction) (nearest town)

WELL PURPOSE: Home
(home, irrigation, municipal, industrial)

WELL COMPLETION DATA:

- (1) diameter (inches) 4
- (2) total depth (feet) 107
- (3) static water level (feet) 70 below above top of ground.
- (4) casing Plastic 101
(material) (depth)
4 if telescope see back.
(size)
- (5) screen 6 101
(length) (depth to top)
4 Plastic
(size) (material)
- (6) pump 1/2 12
(HP) (yield gpm)
Electric
(type power)
- (7) electric log No
(yes or no)
(organization running log)
- (8) how well bottom plugged well

description of formations encountered

from to

<u>Red clay</u>	<u>6</u>	<u>15</u>
<u>Red sand</u>	<u>15</u>	<u>60</u>
<u>Red gravel</u>	<u>60</u>	<u>80</u>
<u>fine sand</u>	<u>80</u>	<u>100</u>
<u>loose sand & gravel</u>	<u>100</u>	<u>107</u>

CODED


SEP 13 1969

MISS. DEPT. OF
WATER CONTROL

DRILLERS REMARKS:

If well telescopes please sketch and show depths.

GROUND LEVEL

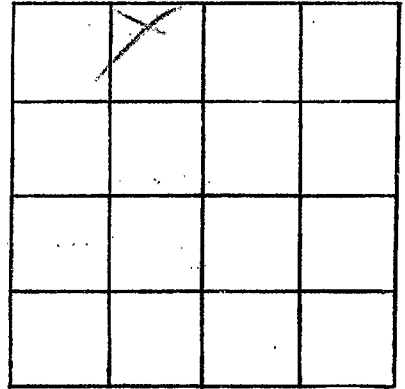

SECTION 23

Please indicate well location X.

ADDITIONAL INFORMATION

If more than one screen,
show locations of each on sketch.