

PIKE
G 71
9-15-69

MISSISSIPPI
BOARD OF WATER COMMISSIONERS
416 North State Street
Jackson, Mississippi 39201

CODED

WATER WELL DRILLERS LOG

Sept 15 1969 Keene Well Drilling Co. Pike
date well completed firm name county well located

LANDOWNER: Fred Robinson
RFD, Magnolia
(mailing address)

description of formations encountered	from	to
Red clay	0	20
Red sand	20	85
Small gravel and sand	85	99

WELL LOCATION:
sec. 32 T. 2 N R. 7 E
1 miles SW Magnolia
(distance) (direction) (nearest town)

WELL PURPOSE: Home
(home, irrigation, municipal, industrial)

- WELL COMPLETION DATA:
- (1) diameter (inches) 4"
 - (2) total depth (feet) 99
 - (3) static water level (feet) 68 below/above top of ground.
 - (4) casing Plastic Bottom
(material) (depth)
 - (size) if telescope see back.
 - (5) screen 6' 93'
(length) (depth to top)
4" Plastic
(size) (material)
 - (6) pump None
(HP) (yield gpm)
 - (type power)
 - (7) electric log No
(yes or no)
 - (organization running log)
 - (8) how well bottom plugged wooden plug


CODED

DRILLERS REMARKS:

REC'D 9-15-69
MISS. DE. OF
WATER

If well telescopes please sketch and show depths.

GROUND LEVEL

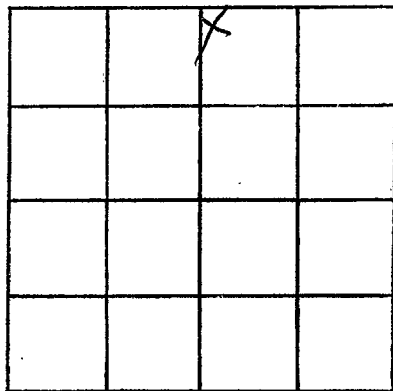

SECTION 32

Please indicate well location X.

ADDITIONAL INFORMATION

If more than one screen,
show locations of each on sketch.