

Pike  
G72  
9-24-69

MISSISSIPPI  
BOARD OF WATER COMMISSIONERS  
416 North State Street  
Jackson, Mississippi 39201

**CODED**

WATER WELL DRILLERS LOG

Pike

9-24  
date well completed

1969

F. Howell Well Co.  
firm name

Carroll  
county well located

LANDOWNER:

Jae Waterman  
R.R. Magnolia, Miss.  
(mailing address)

description of formations encountered

from

to

Red clay	0	15
Red sand	15	60
Red gravel	60	90
Red sand	90	115
Loose sand & gravel	115	126

WELL LOCATION:

sec. 31 T 2 N R 7 E  
S W  
8 miles SW of Magnolia  
(distance) (direction) (nearest town)

WELL PURPOSE: Home  
(home, irrigation, municipal, industrial)

WELL COMPLETION DATA:

- (1) diameter (inches) 4
- (2) total depth (feet) 126
- (3) static water level (feet) 70 below top of ground.
- (4) casing (material) plastic, (depth) 118  
4 (size) if telescope see back.
- (5) screen (length) 8, (depth to top) 118  
4 (size) plastic (material)
- (6) pump 1/2 (HP), 12 (yield gpm)  
Elev (type power)
- (7) electric log (yes or no) no  
(organization running log)
- (8) how well bottom plugged: 5' red py

**CODED**


OGT 2

Misc. Bd. C.  
WATER COMM.

DRILLERS REMARKS:

If well telescopes please sketch and show depths.

GROUND LEVEL

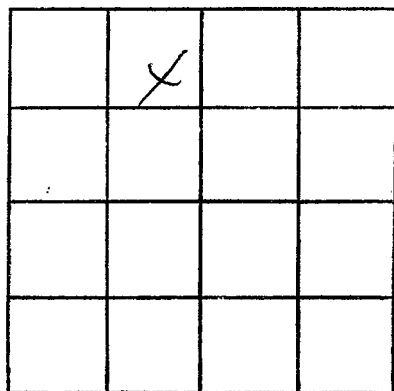

SECTION

~~4~~ 31

Please indicate well location X.

ADDITIONAL INFORMATION

If more than one screen,  
show locations of each on sketch.