

MISSISSIPPI
BOARD OF WATER COMMISSIONERS
416 North State Street
Jackson, Mississippi 39201

CODED

WATER WELL DRILLERS LOG

PIKE
G 73
1-12-70

1-12 1970
date well completed

Fitzgerald well serv
firm name

Pike
county well located

LANDOWNER:

Rees Martin
B.B. Magnolia miss
(mailing address)

description of formations encountered

from to

<u>Red clay</u>	<u>0</u>	<u>20</u>
<u>Red sand</u>	<u>20</u>	<u>60</u>
<u>Red gravel</u>	<u>60</u>	<u>70</u>
<u>Coarse sand & gravel</u>	<u>70</u>	<u>120</u>
<u>Red sand</u>	<u>120</u>	<u>130</u>
<u>Coarse sand & gravel</u>	<u>130</u>	<u>140</u>

WELL LOCATION:

sec 20 T 2 N R 7 E W
5 miles W of Magnolia
(distance) (direction) (nearest town)

WELL PURPOSE: Home
(home, irrigation, municipal, industrial)

WELL COMPLETION DATA:

- (1) diameter (inches) 4
- (2) total depth (feet) 140
- (3) static water level (feet) 120 below above top of ground.
- (4) casing Plastic, 133 (material) (depth)
4 if telescope see back. (size)
- (5) screen 8, 133 (length) (depth to top)
4 (size), Plastic (material)
- (6) pump 1 (HP), 6 (yield gpm)
elec (type power)
- (7) electric log No (yes or no)
(organization running log)
- (8) how well bottom plugged Good plug



CODED

JAN 20 1970

MISS. BD. OF
WATER COMMISSIONERS

DRILLERS REMARKS:

If well telescopes please sketch and show depths.

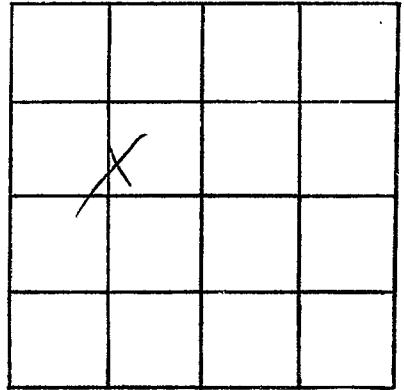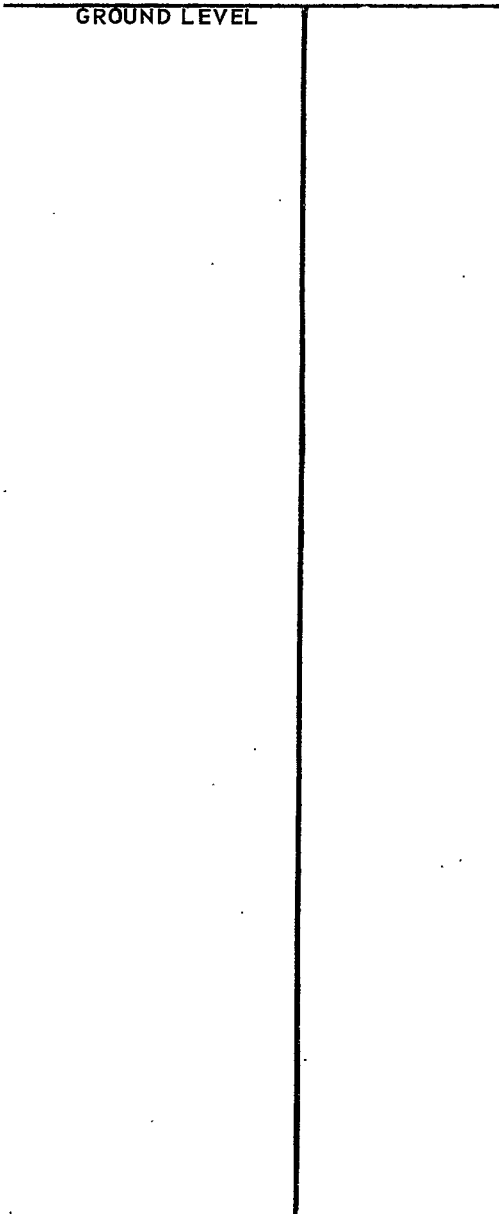

SECTION 20

Please indicate well location X.

ADDITIONAL INFORMATION

A series of horizontal lines for additional information.

If more than one screen, show locations of each on sketch.